

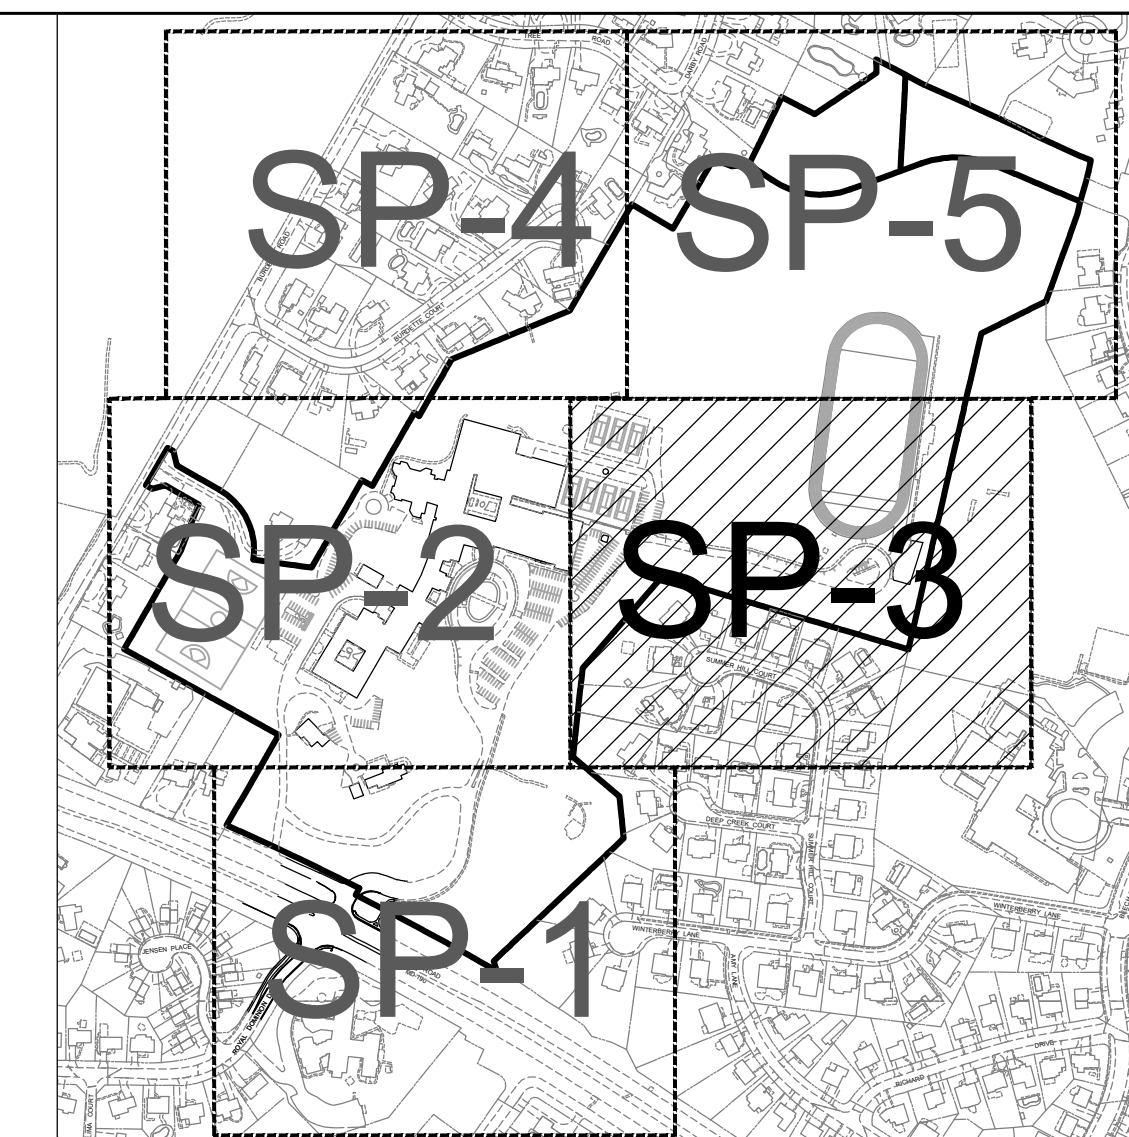


LINE	BEARING	DISTANCE
1	N 89° 17' 21" E	15.95
2	N 89° 17' 21" E	15.95
CURVE	RADIUS	ARC LENGTH	CHORD LENGTH	CHORD BEARING	DELTA ANGLE
1	100.00	1.5708	1.0000	N 89° 17' 21" E	27.0000
2	100.00	1.5708	1.0000	N 89° 17' 21" E	27.0000
3	100.00	1.5708	1.0000	N 89° 17' 21" E	27.0000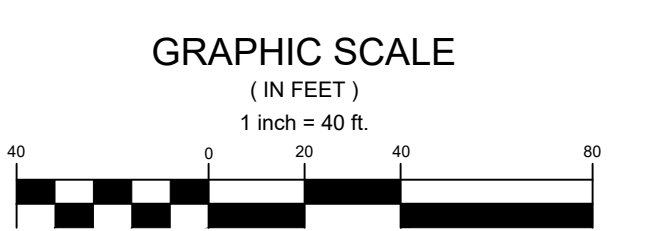
DRAWING KEY

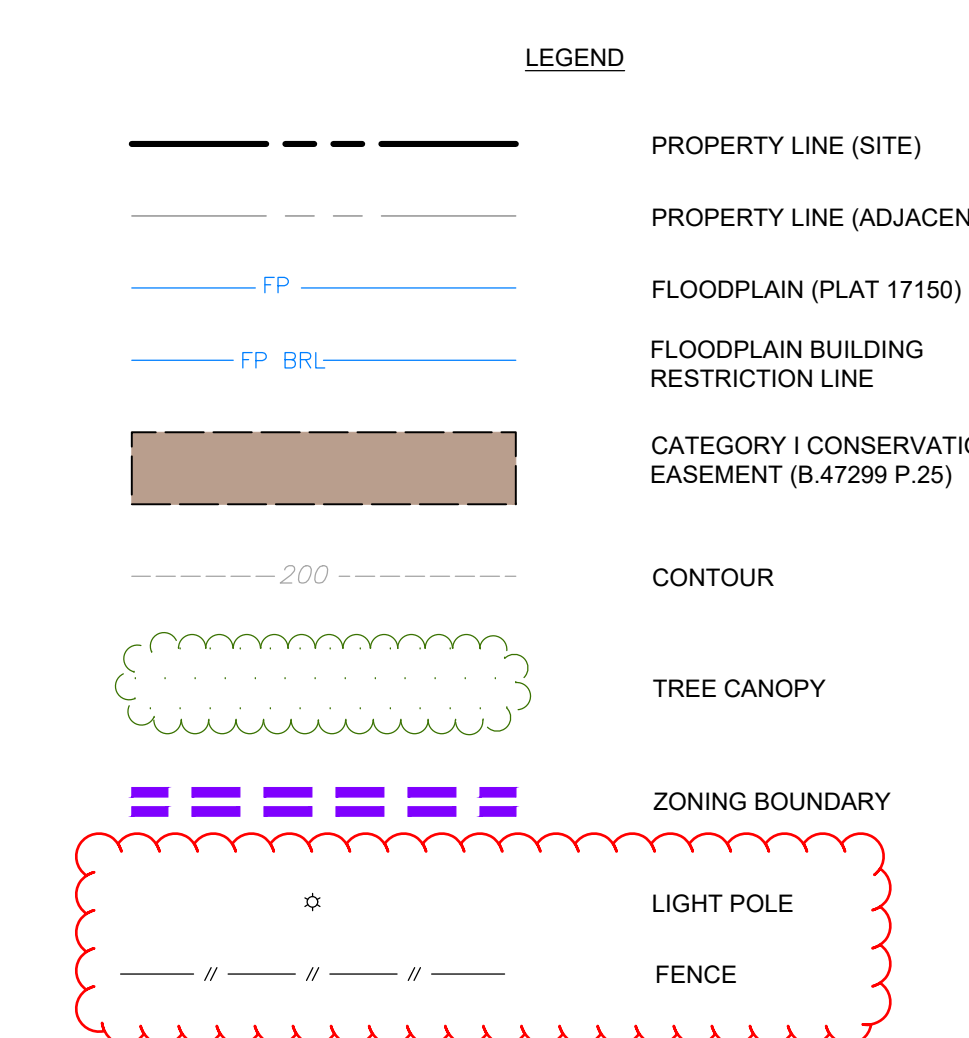

TAX MAP GNS3 WSSC 210R07

PLAT 24741

7TH ELECTION DISTRICT
MONTGOMERY COUNTY
MARYLAND

**PARCEL 4
BURNING TREE VALLEY
HOLTON-ARMS SCHOOL &
PARCELS 1 & 2
B.15417 P.146**

PROJ. MGR PGL
DRAWN BY PGL
SCALE 1" = 150'
DATE 03.31.2026

EXISTING CONDITIONS
SITE PLAN

SP1.03
PROJECT NO. 05.133.21
SHEET NO. 3 OF 5

I:\05133\05133\SP_1_01.dwg, SP_1.03, 4/10/2025 2:05:37 PM, Jengap, Copyright © 2025 Macris, Hendricks & Geisock, P.A.