
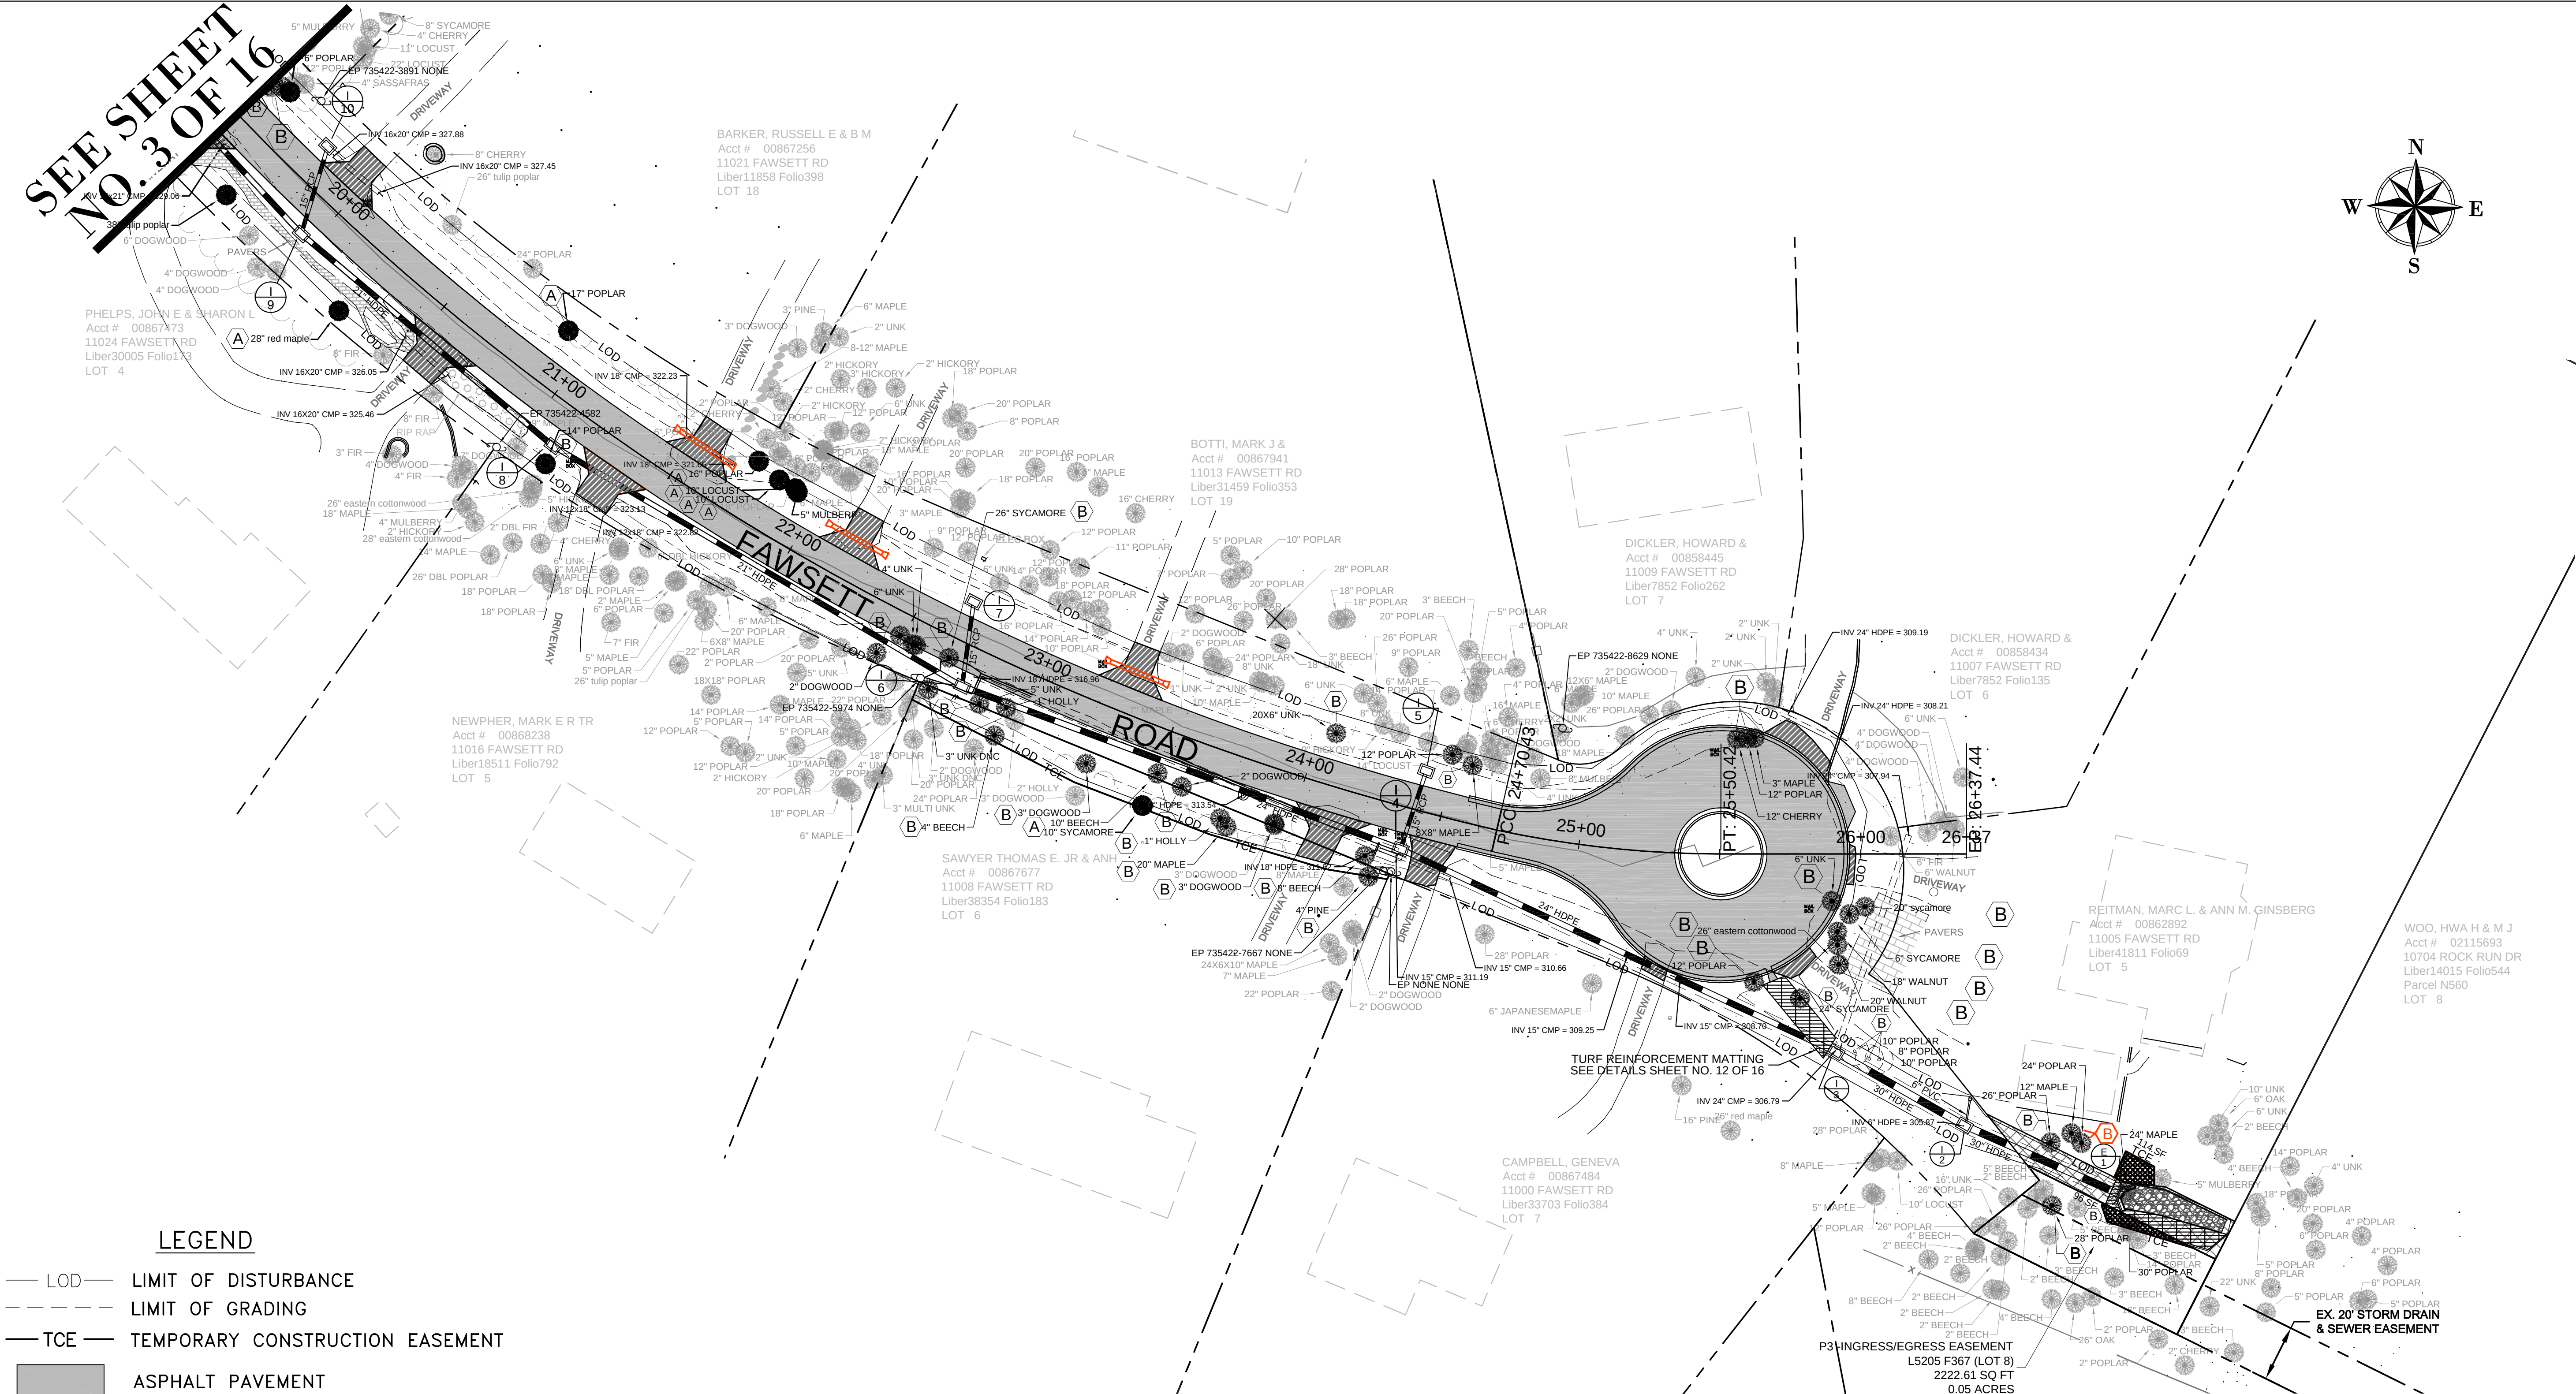


SEE SHEET
NO. 3 OF 16

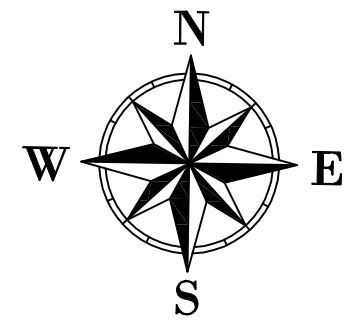

LEGEND

- LOD — LIMIT OF DISTURBANCE
- - - - - LIMIT OF GRADING
- TCE — TEMPORARY CONSTRUCTION EASEMENT
- ASPHALT PAVEMENT
- DRIVEWAY REPAVEMENT
- TURF REINFORCEMENT MATTING
- PROPOSED STORM DRAIN EASEMENT
- EX. INGRESS/EGRESS EASEMENT

NOTE

- TREATMENT (A): RETAIN TREE IN PLACE AND PROTECT DURING CONSTRUCTION
- TREATMENT (B): REMOVE TREE INCLUDING STUMP

MONTGOMERY CO. DEPARTMENT OF PERMITTING SERVICES APPROVED FOR:		NOTE: MCDPS APPROVAL DOES NOT NEGATE THE NEED OF A MCDPS ACCESS PERMIT.
Stormwater Management:	Sediment Control Technical Requirements:	Administrative Requirements:
Reviewed _____ Date _____	Reviewed _____ Date _____	Reviewed _____ Date _____
Approved _____ Date _____	Approved _____ Date _____	Approved _____ Date _____
253273 S.M.F. FILE NO.		

1. INSTALL DRIVEWAY CULVERTS 8-13-14 RSP	2. REMOVE THE TWO TREES 8-13-14 RSP	MONTGOMERY COUNTY DEPARTMENT OF TRANSPORTATION GAITHERSBURG, MARYLAND		PV02-PLAN VIEW FAWSETT ROAD IMPROVEMENT STA 19+50 TO STA 26+37	
		RECOMMENDED FOR APPROVAL			
		Chief, Design Section APPROVED _____ Date _____			
		Chief, Division of Transportation Engineering APPROVED _____ Date _____			
		Designed by: RSP Drawn by: RSP Checked by: _____		SCALE: 1"=30' DATE: MAY 2014	
NO. REVISION DATE BY		Project No.: 501117 SHEET 4 of 16			