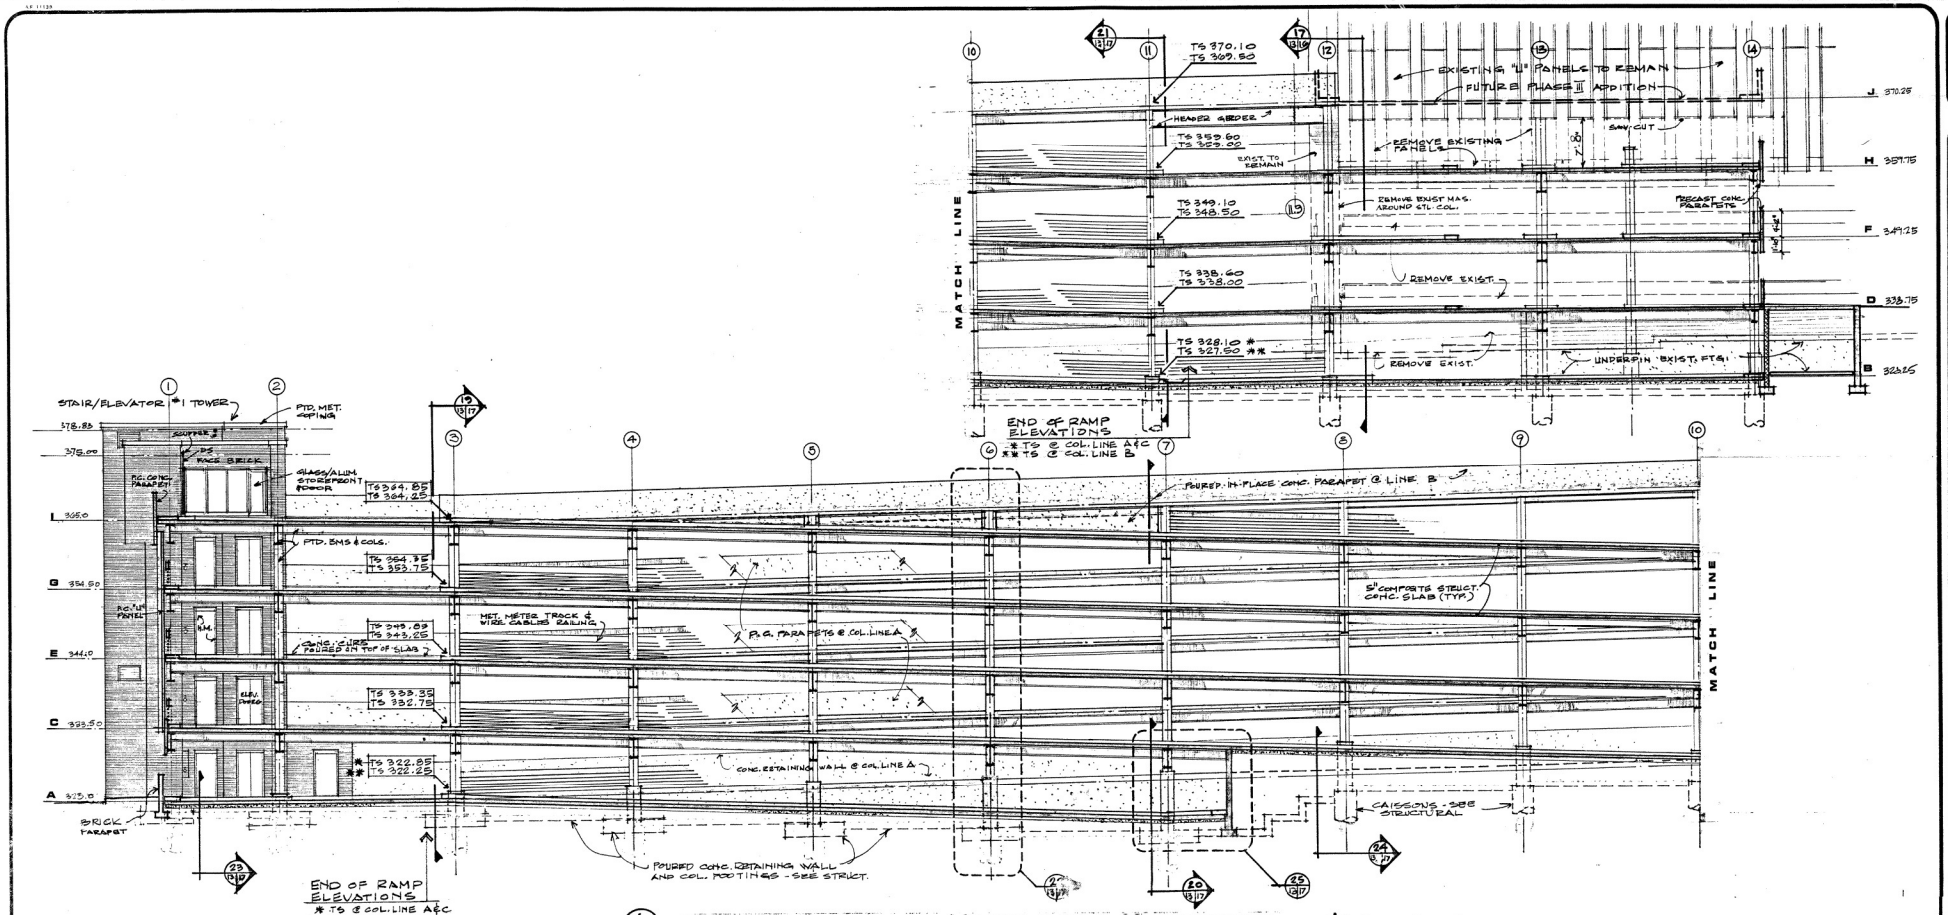

LONGITUDINAL BUILDING SECTION 1/8" = 1'-0"

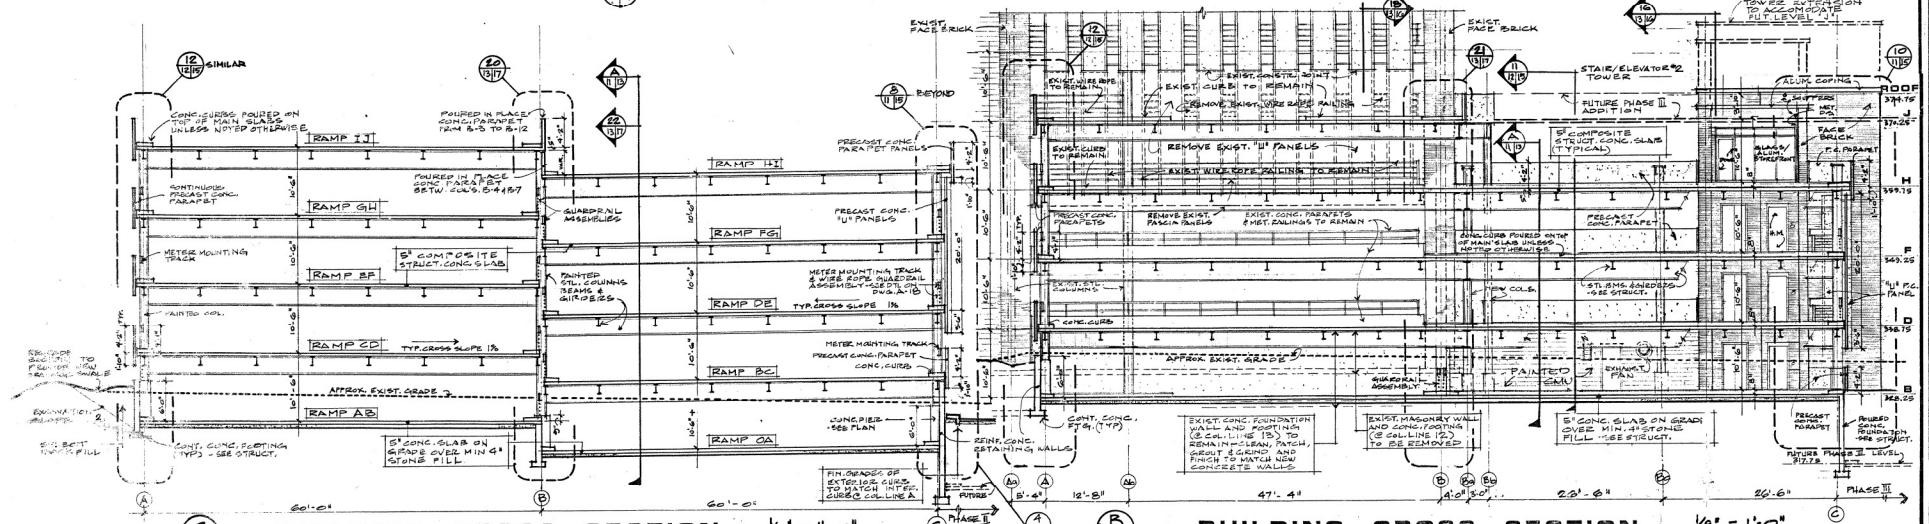

BUILDING CROSS SECTION 1/8" = 1'-0"

BUILDING CROSS SECTION 1/8" = 1'-0"

LEWIS / BOUQUET
ARCHITECTS AND PLANNERS
7315 WISCONSIN AVE., BETHESDA, MD. 301-657-8000

Meyer Associates
Structural Engineers

SILVER SPRING GARAGE #2, PHASE II
DEPARTMENT OF TRANSPORTATION, DIVISION OF PARKING

J10405

A-13

7/23/82
5/20/83
6/24/83
8/13/81
9/11/81

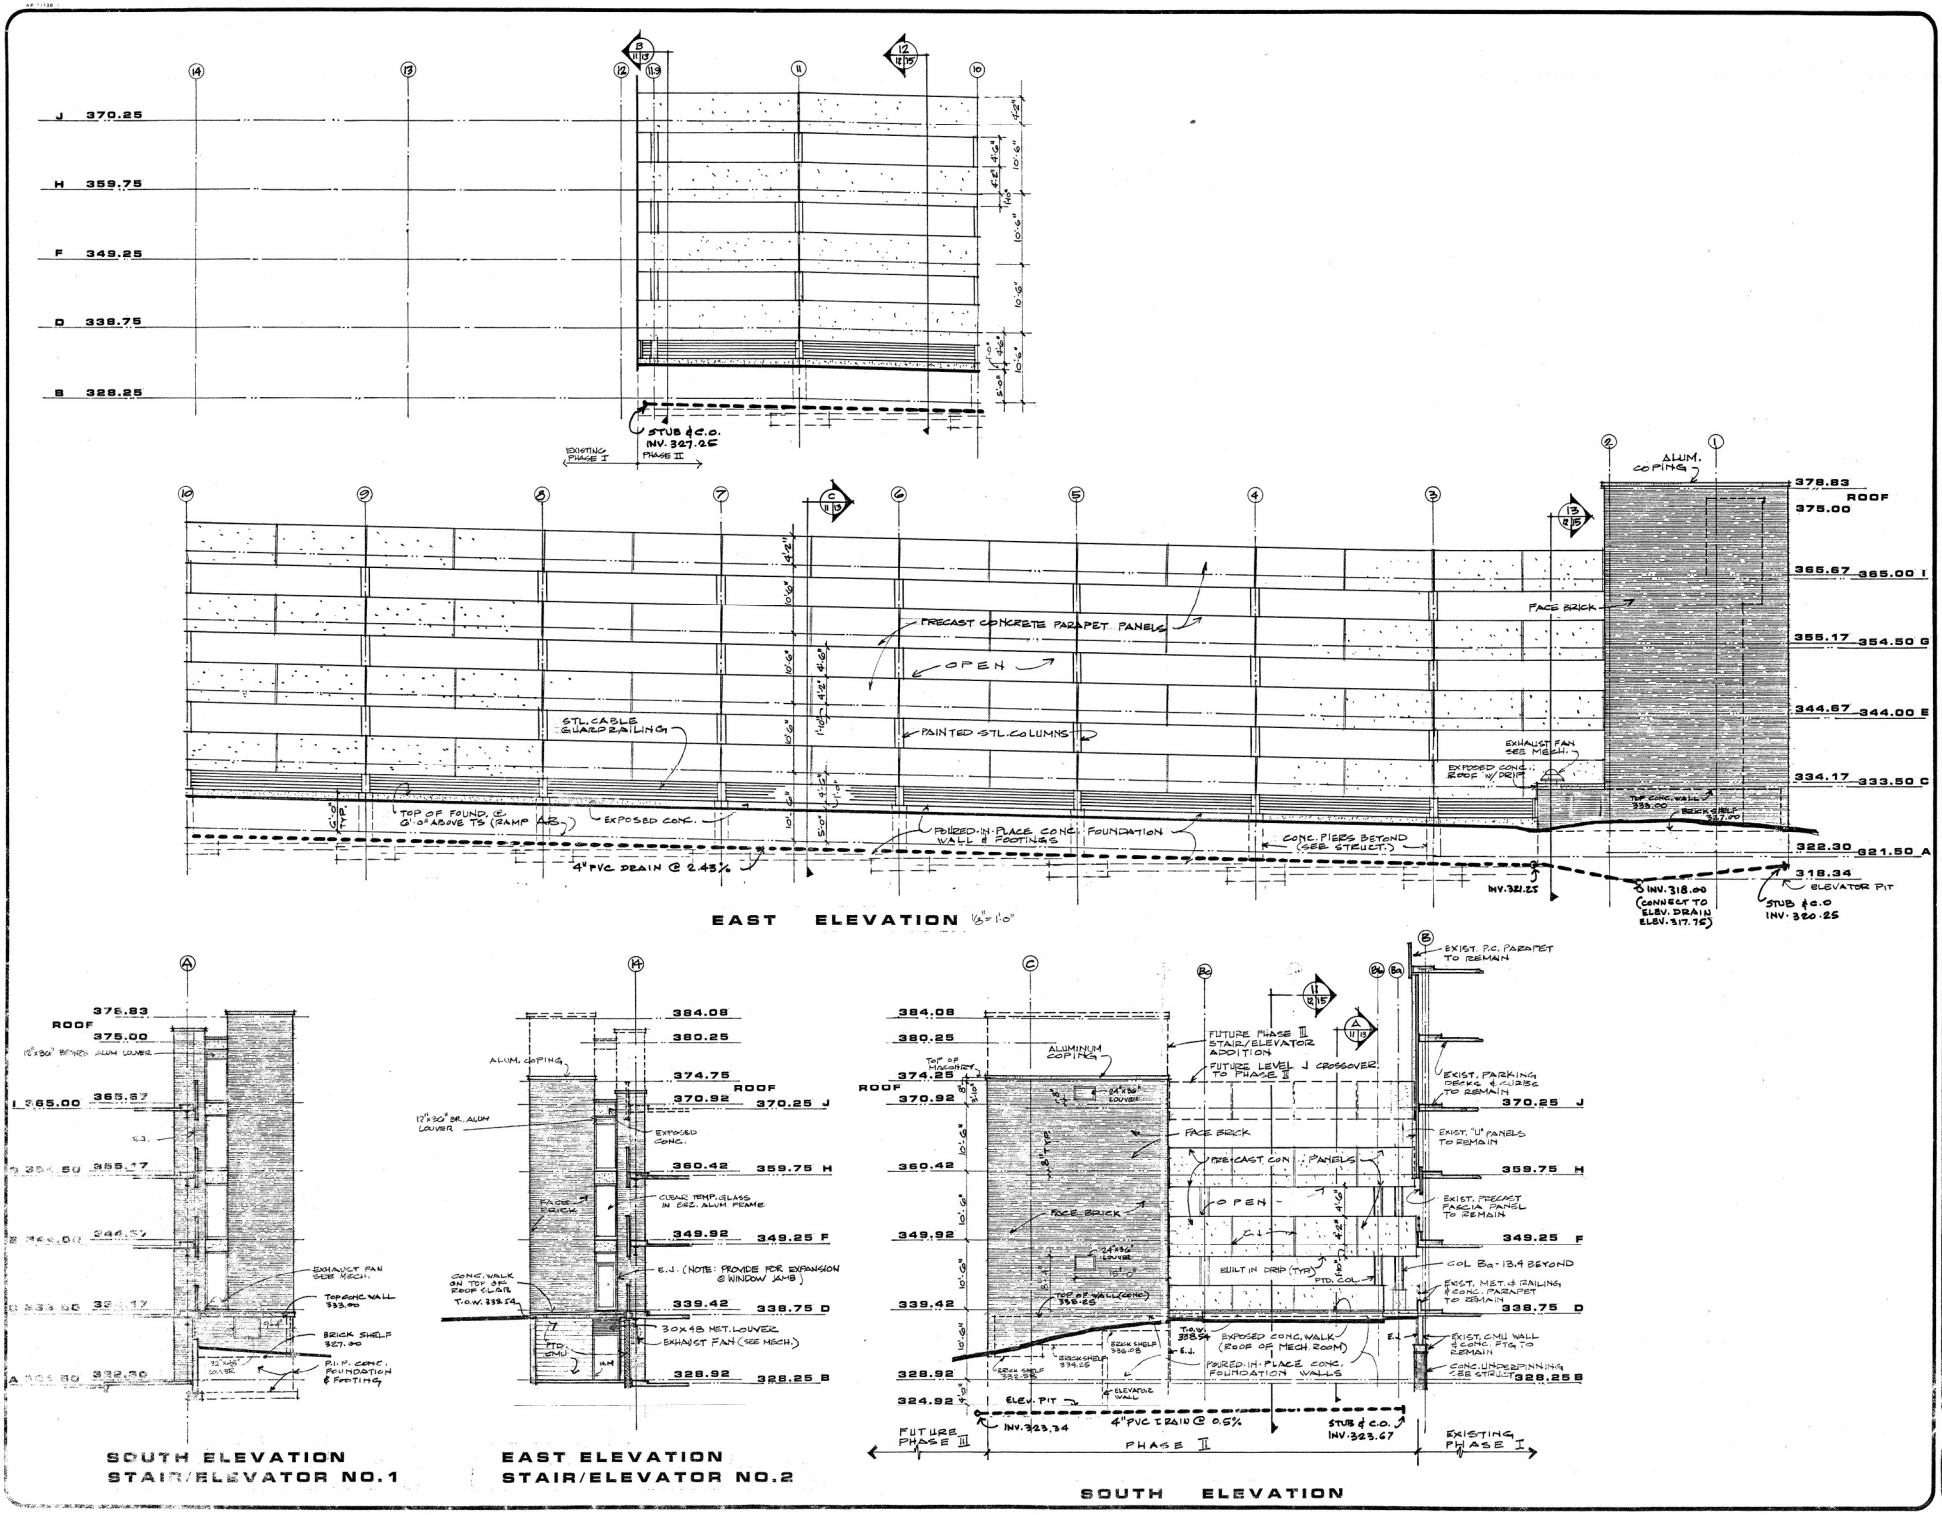

LEWIS / BOUQUET
ARCHITECTS AND PLANNERS
4318 WISCONSIN AVE., BETHESDA, MD 301/657-8800

Meyer Associates
Structural Engineers

SILVER SPRING GARAGE #2, PHASE II
DEPARTMENT OF TRANSPORTATION, DIVISION OF PARKING

J10405

A-12

7/23/82
5/26/83
9/30/83

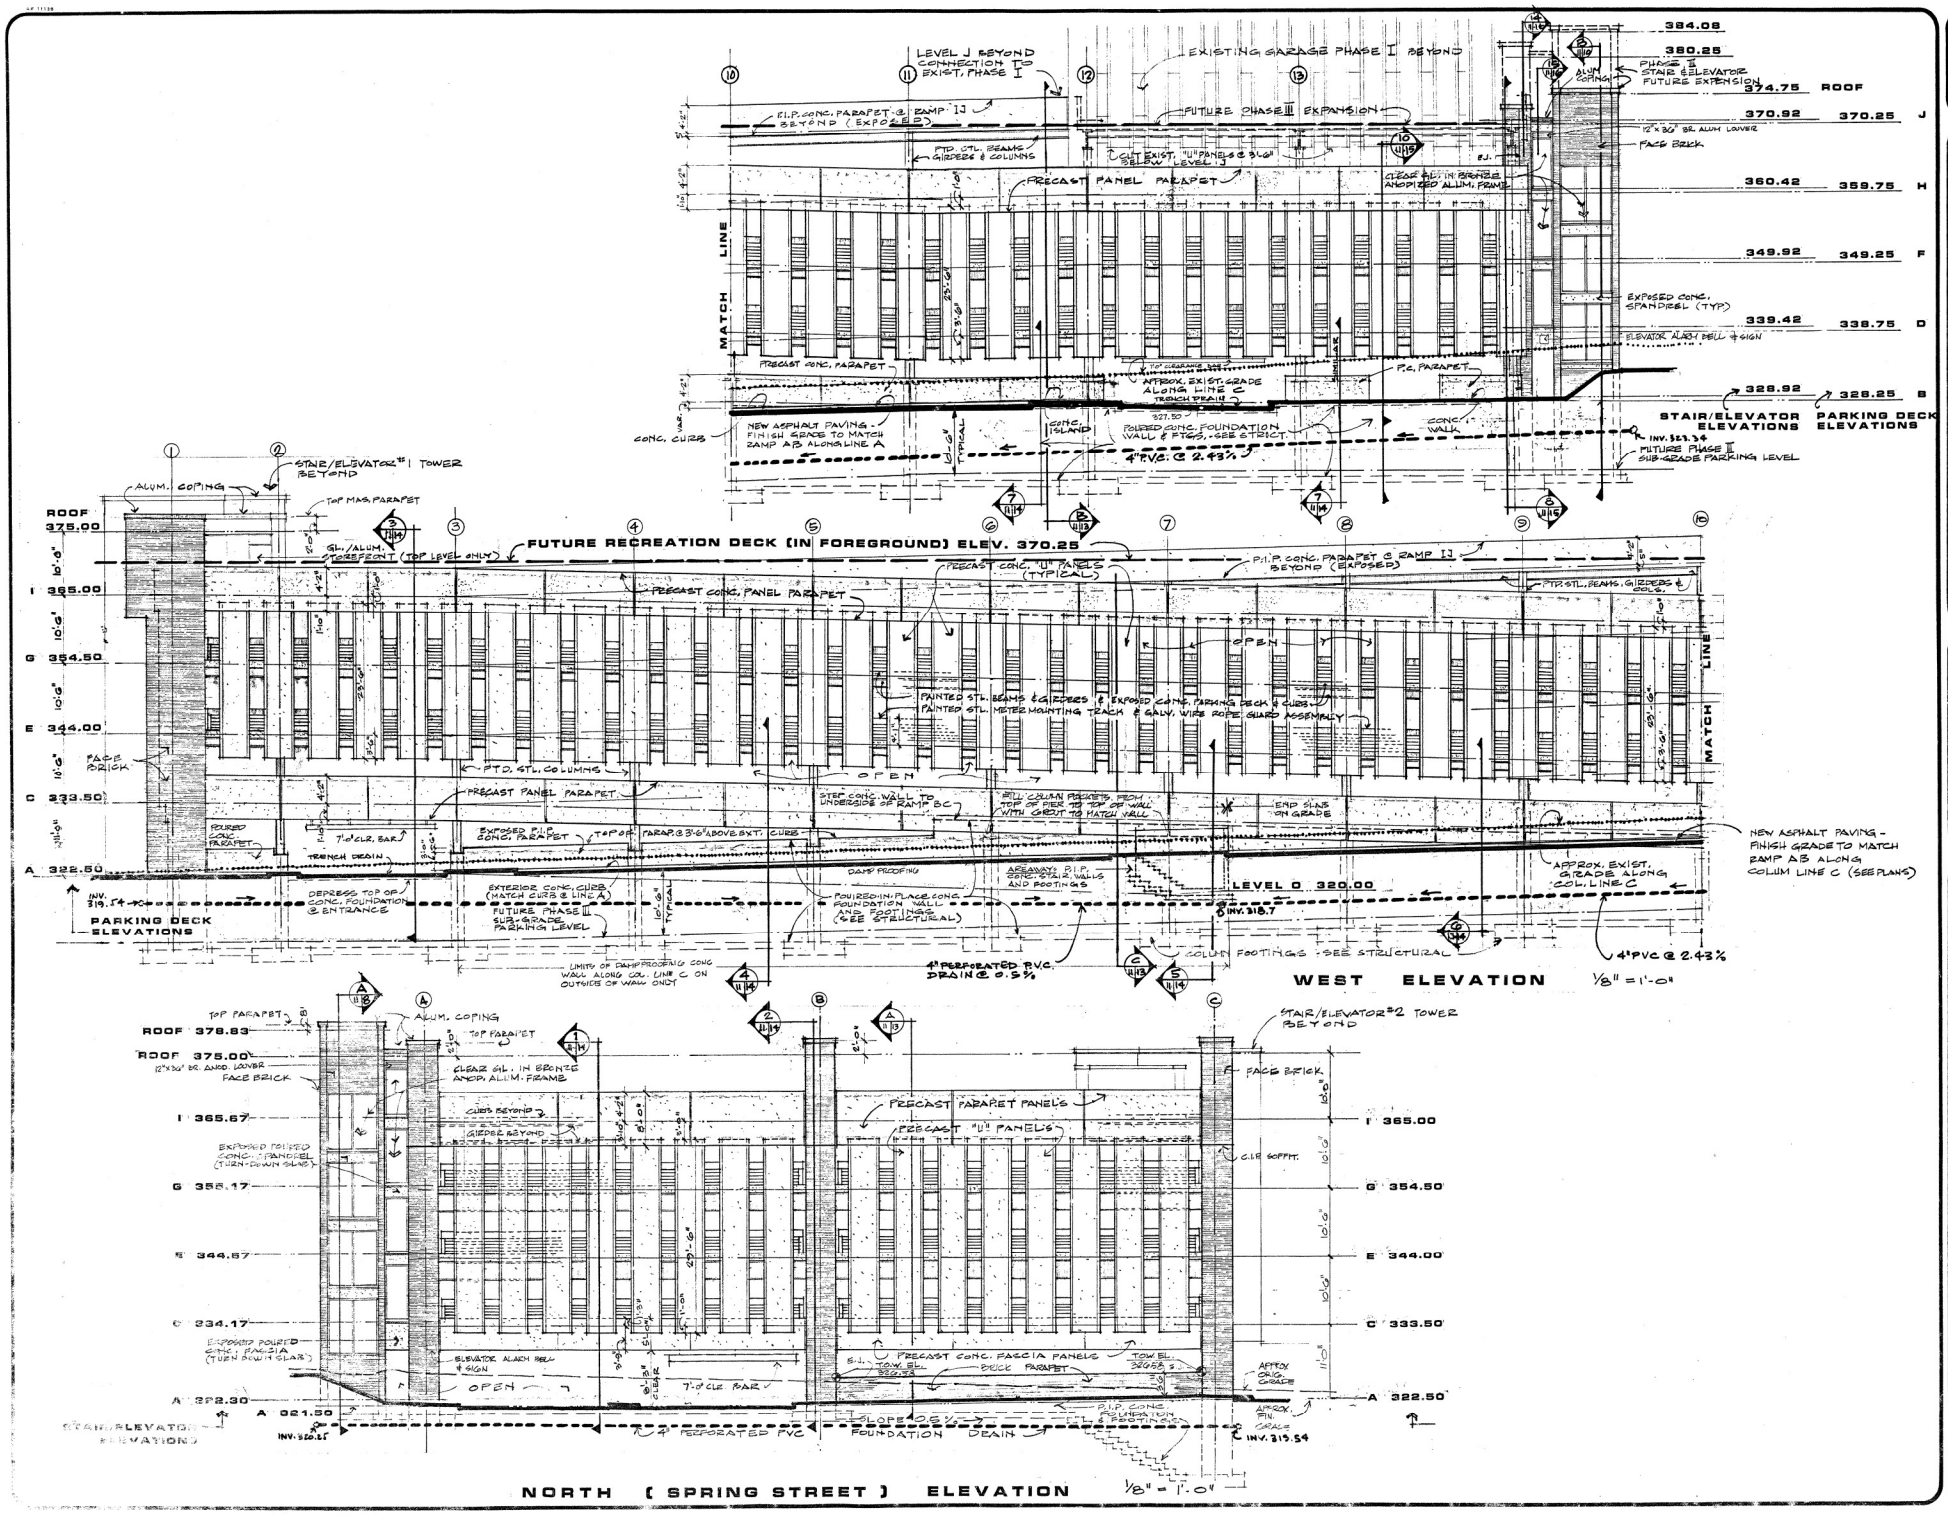

LEWIS / BOUQUET
ARCHITECTS AND PLANNERS
7315 WISCONSIN AVE. BETHESDA, MD. 301-657-8800

Meyer Associates
Structural Engineers

SILVER SPRING GARAGE #2, PHASE II
DEPARTMENT OF TRANSPORTATION, DIVISION OF PARKING

J10405

A-11

7/23/82
5/20/83
6/30/83

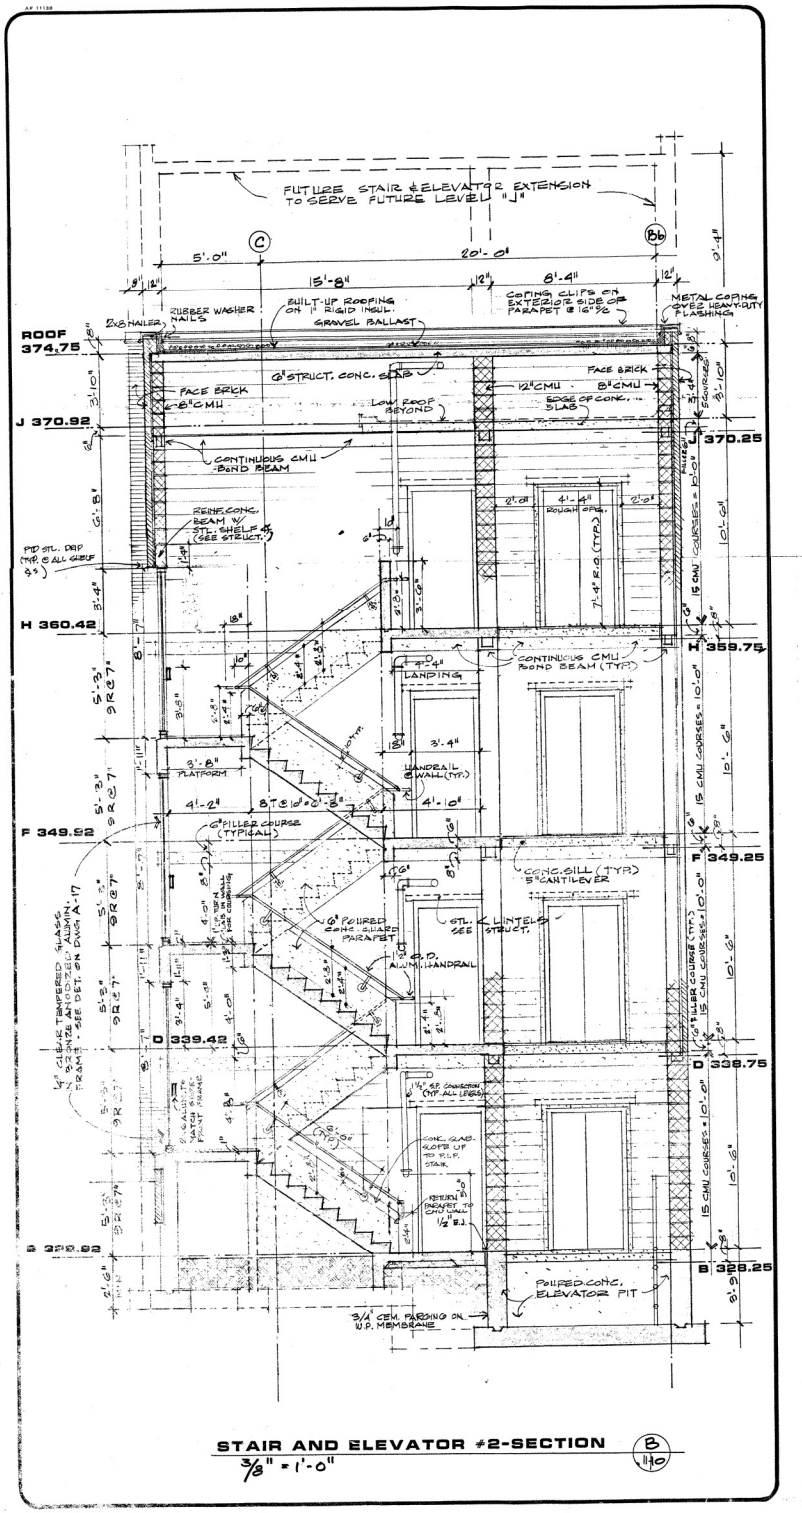

STAIR AND ELEVATOR #2-SECTION (B 11/10)
3/8" = 1'-0"

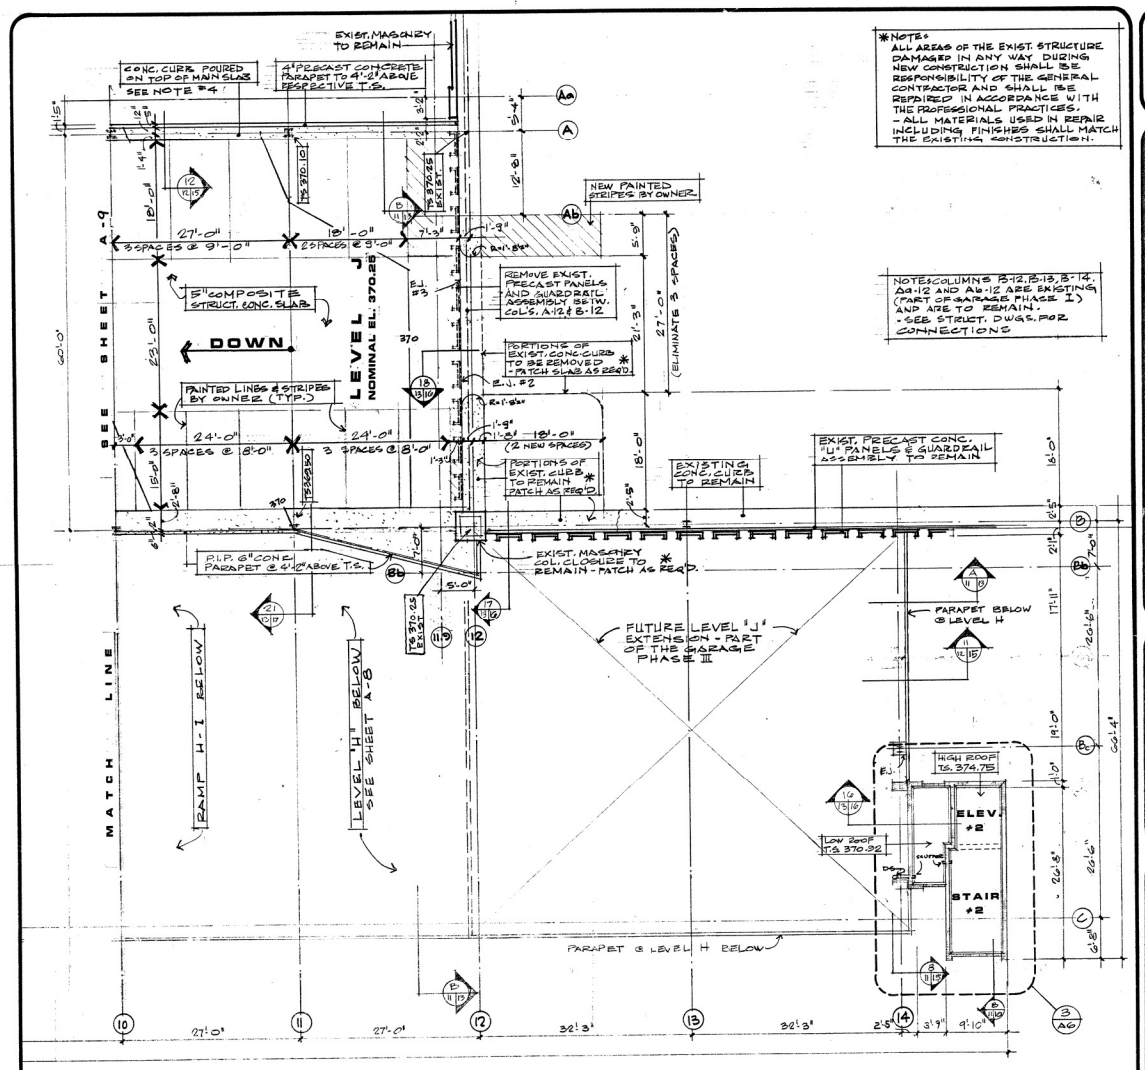

LEVEL J 1/8" = 1'-0"
370.25

*NOTE:
ALL AREAS OF THE EXIST. STRUCTURE DAMAGED IN ANY WAY DURING NEW CONSTRUCTION SHALL BE RESPONSIBILITY OF THE GENERAL CONTRACTOR AND SHALL BE REPAIRED IN ACCORDANCE WITH THE PROFESSIONAL PRACTICES.
- ALL MATERIALS USED IN REPAIR INCLUDING FINISHES SHALL MATCH THE EXISTING CONSTRUCTION.

NOTE: COLUMNS B-12, B-13, B-14, Aa-12 AND Ab-12 ARE EXISTING (PART OF GARAGE PHASE I) AND ARE TO REMAIN.
- SEE STRUCT. DWGS. FOR CONNECTIONS

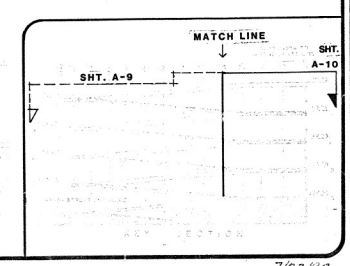

LEWIS / BOUQUET
ARCHITECTS AND PLANNERS
7315 WISCONSIN AVE., BETHESDA, MD. 301 657-8800

Meyer Associates
Structural Engineers

SILVER SPRING GARAGE #2, PHASE II
DEPARTMENT OF TRANSPORTATION, DIVISION OF PARKING

J10405
A-10

7/23/82
5/20/83
6/30/83
8/13/81
9/11/81

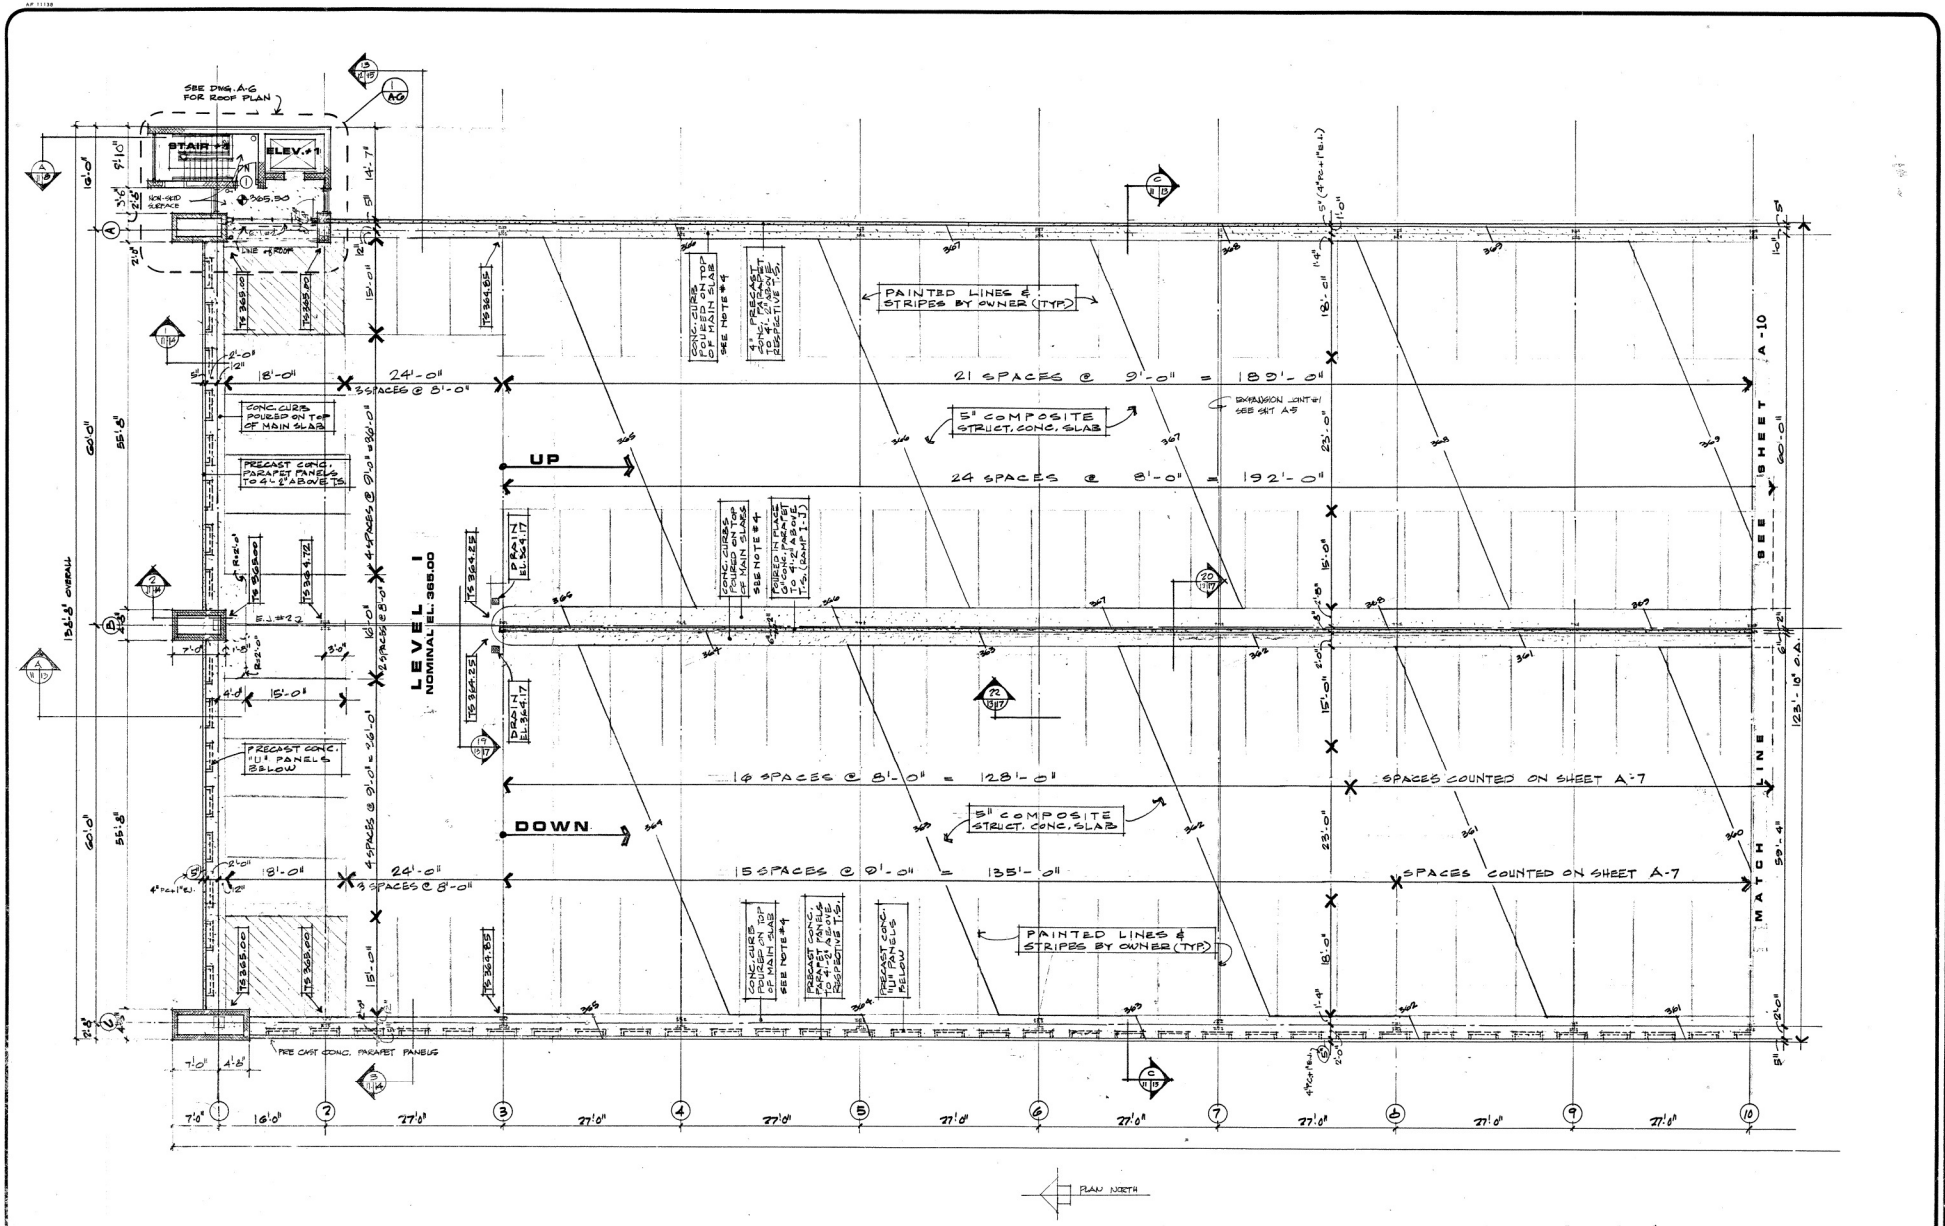

LEVEL I 1/8"=1'0"

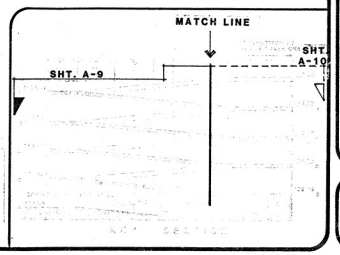

LEWIS / BOUCUET
ARCHITECTS AND PLANNERS
7338 WISCONSIN AVE. BETHESDA, MD. 301 657 8800

Meyer Associates
Structural Engineers

SILVER SPRING GARAGE #2, PHASE II
DEPARTMENT OF TRANSPORTATION, DIVISION OF PARKING

J10405
A-9

7/22/82
5/20/83
8/13/81
9/11/81

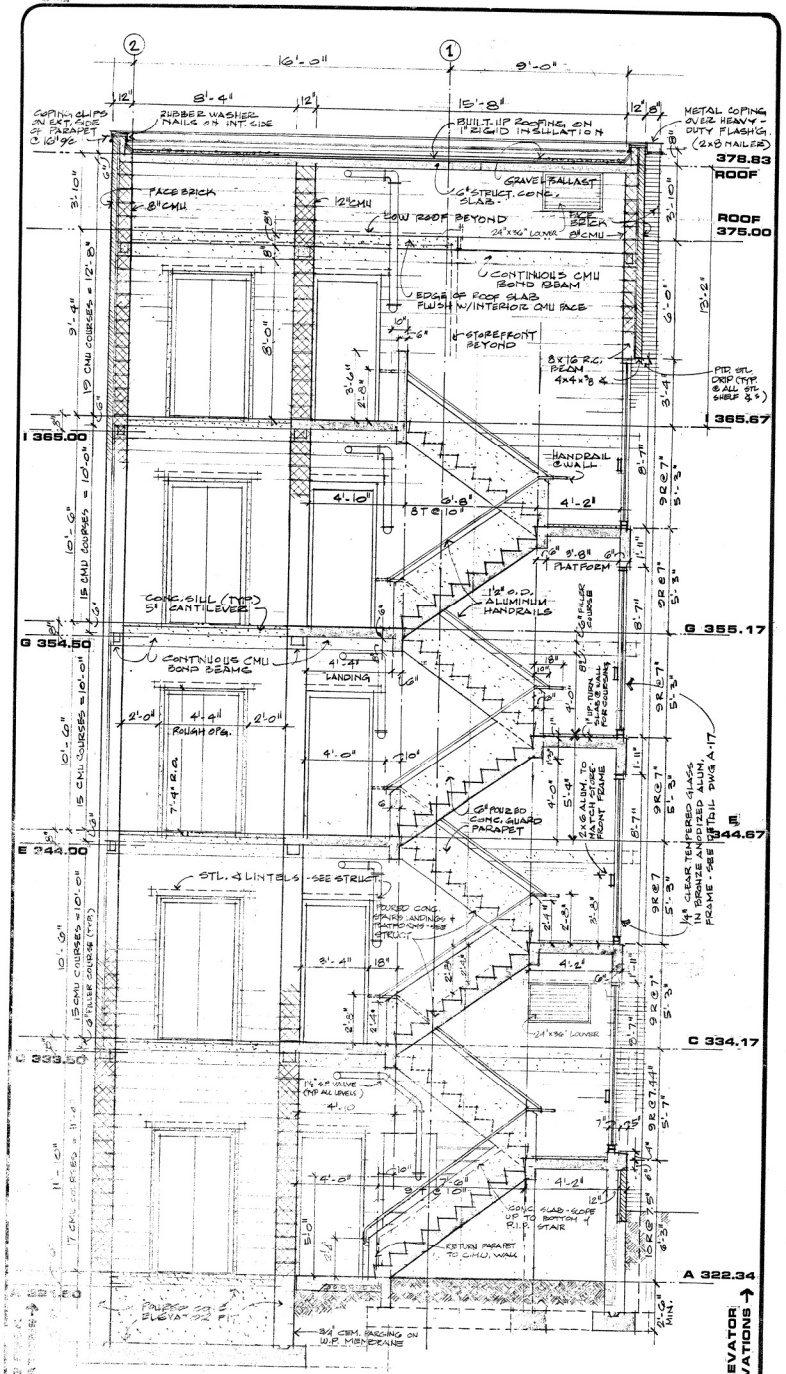

STAIR AND ELEVATOR #1 - SECTION

3/8" = 1'-0"

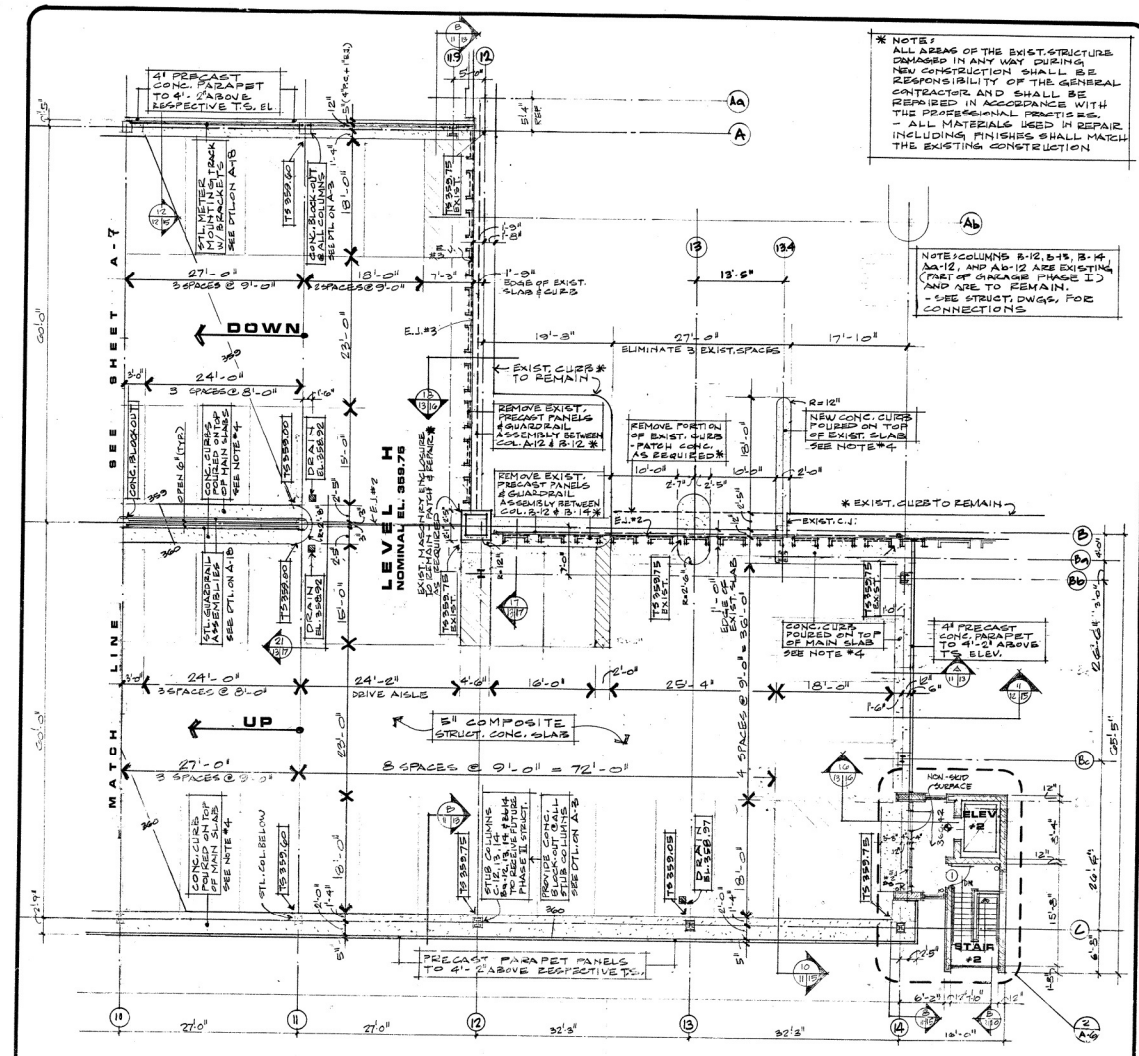

LEVEL H 1/8" = 1'-0"

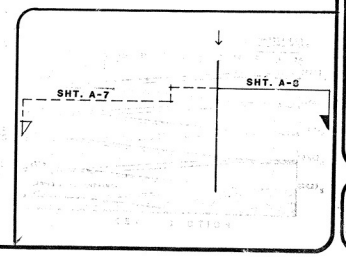

* NOTE: ALL AREAS OF THE EXIST. STRUCTURE DAMAGED IN ANY WAY DURING NEW CONSTRUCTION SHALL BE RESPONSIBILITY OF THE GENERAL CONTRACTOR AND SHALL BE REPAIRED IN ACCORDANCE WITH THE PROFESSIONAL PRACTICES.
- ALL MATERIALS USED IN REPAIR, INCLUDING FINISHES SHALL MATCH THE EXISTING CONSTRUCTION

LEWIS/BOUQUET
ARCHITECTS AND PLANNERS
7316 WISCONSIN AVE. BETHESDA, MD. 301 657 8888

Meyer Associates
Structural Engineers

SILVER SPRING GARAGE #2, PHASE II
DEPARTMENT OF TRANSPORTATION, DIVISION OF PARKING

J10405

A-8

7/23/82

8/13/81

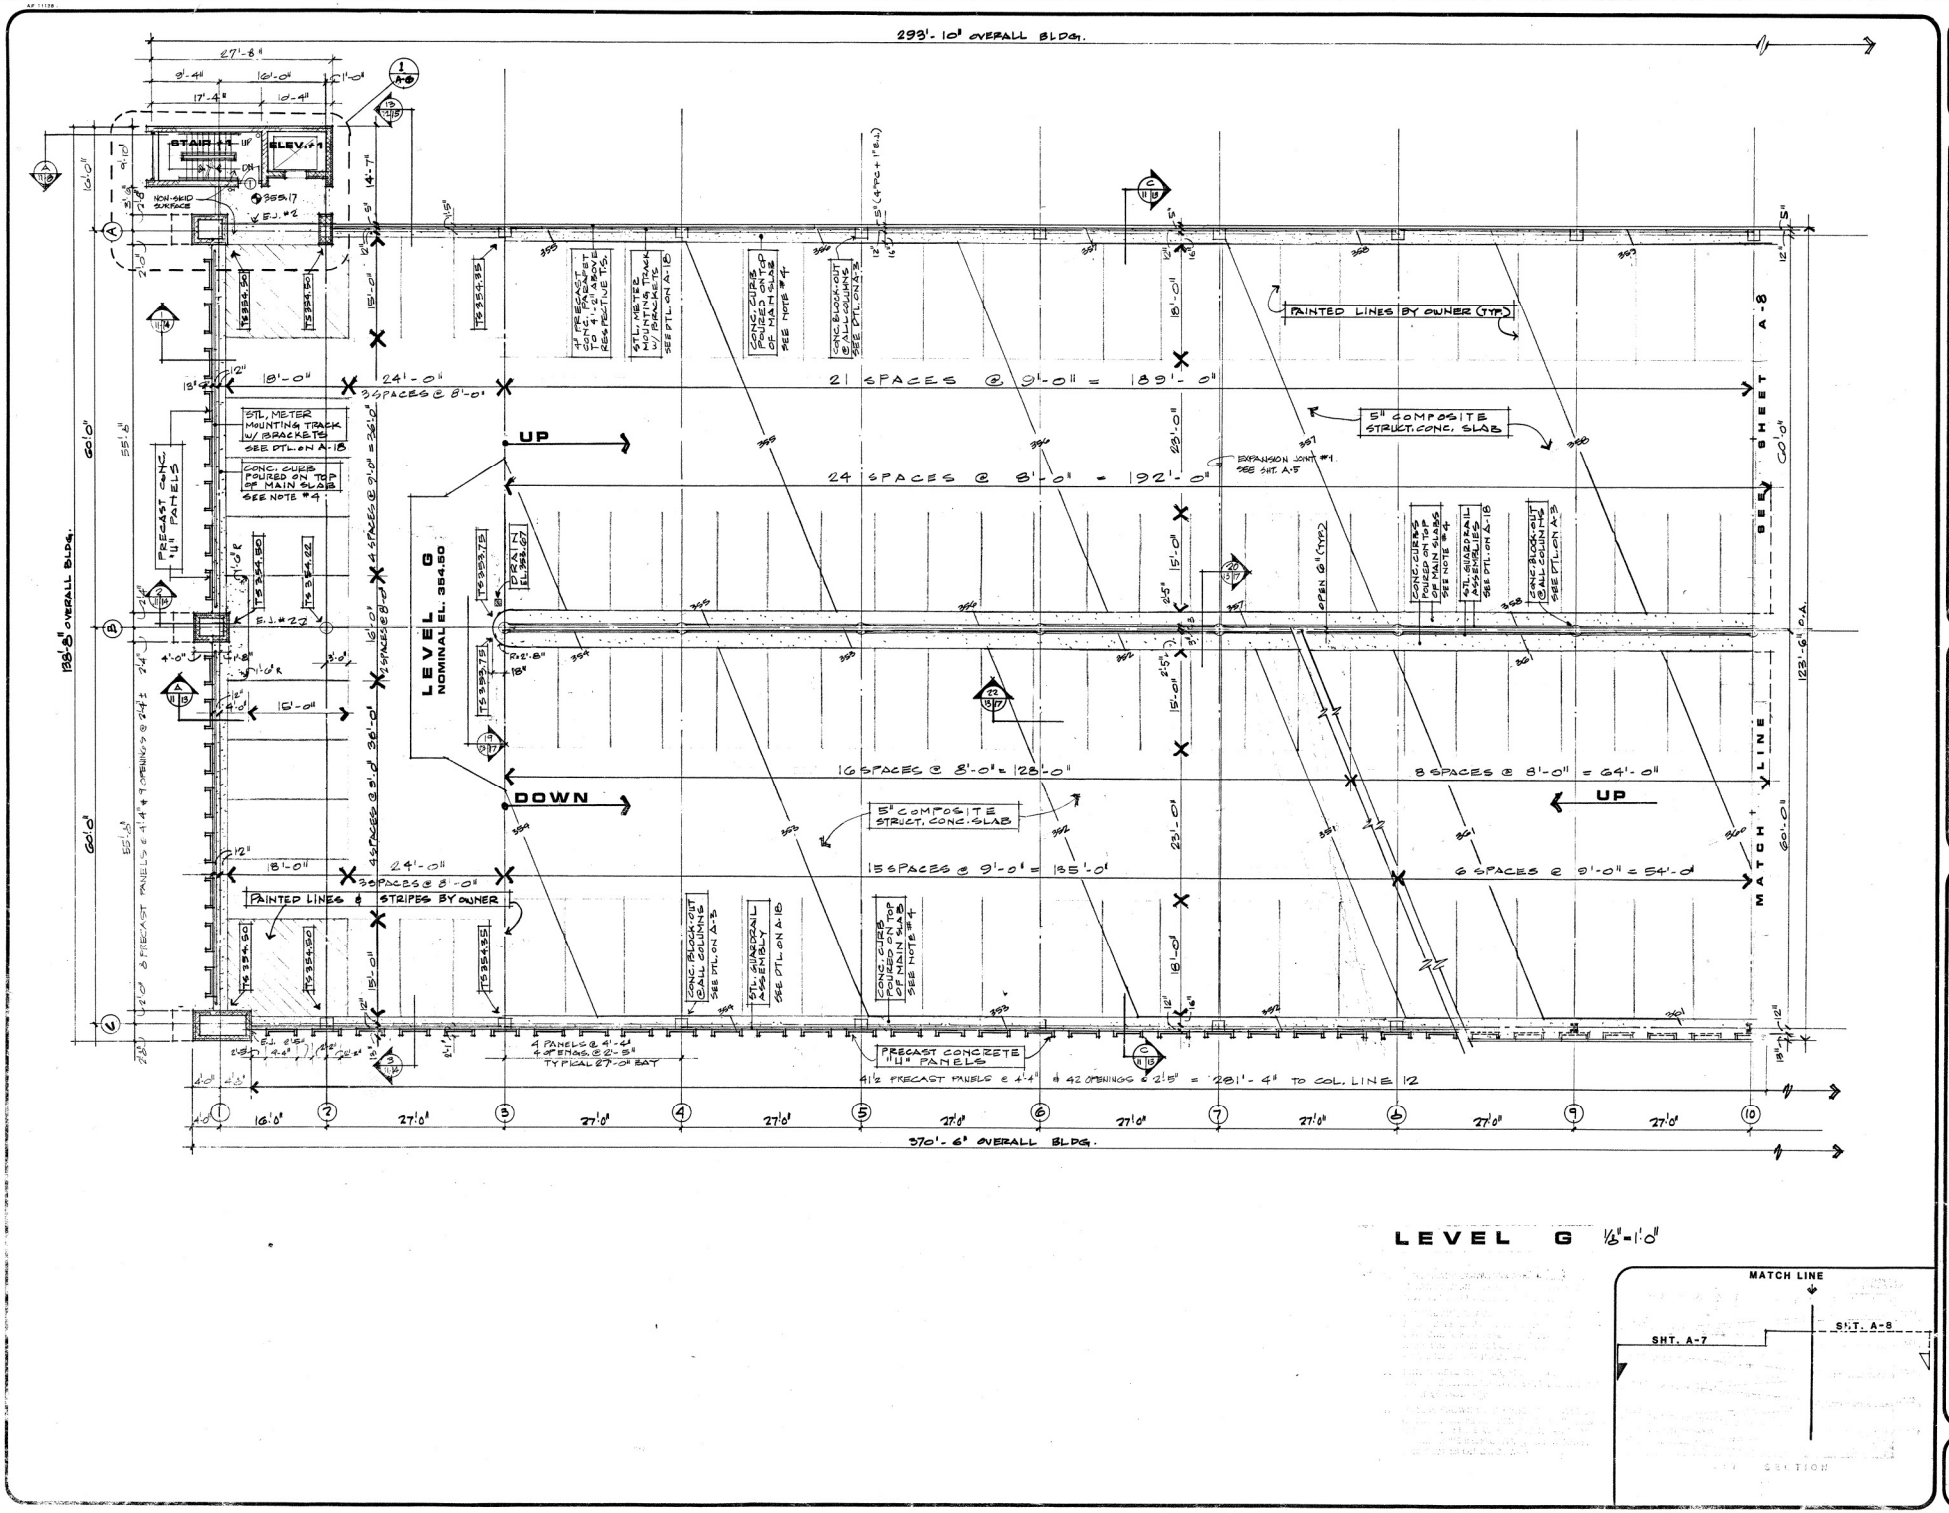

LEWIS / BOUQUET
ARCHITECTS AND PLANNERS
7315 WISCONSIN AVE. BETHESDA MD 301 657-8800

Meyer Associates
Structural Engineers

SILVER SPRING GARAGE #2, PHASE II
DEPARTMENT OF TRANSPORTATION, DIVISION OF PARKING

J10405
A-7

7/23/82
5/20/83
6/30/83

8/13/81
9/11/81

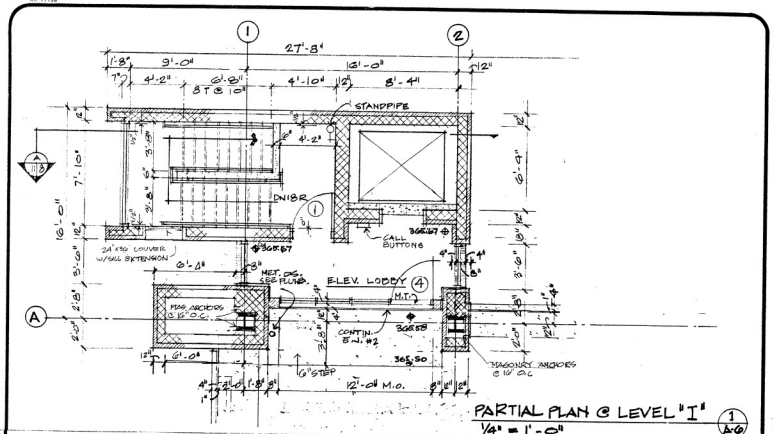

PARTIAL PLAN @ LEVEL "I" 1/A-6
1/4" = 1'-0"

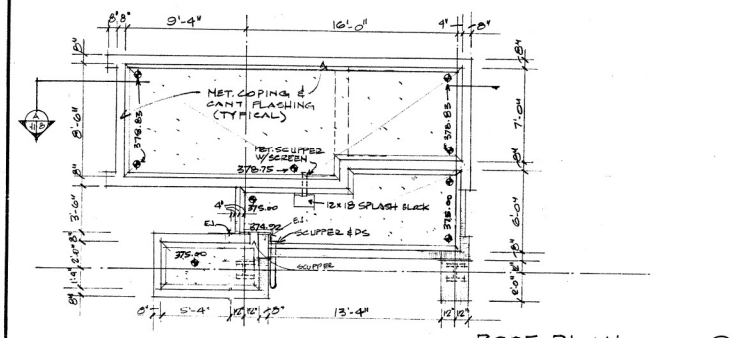

ROOF PLAN 4/A-6
1/4" = 1'-0"

STAIR & ELEVATOR Nº 1

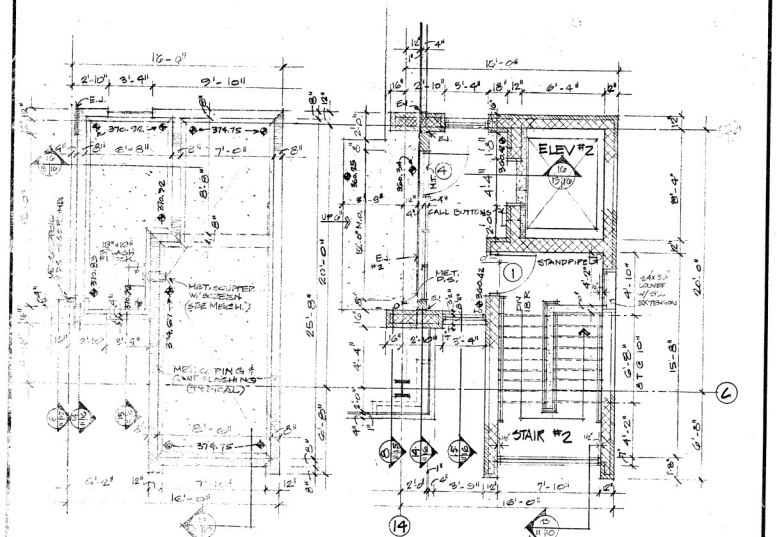

ROOF PLAN 3/A-6

PARTIAL PLAN @ LEVEL "H" 1/4" = 1'-0" 2/A-6

STAIR & ELEVATOR Nº 2

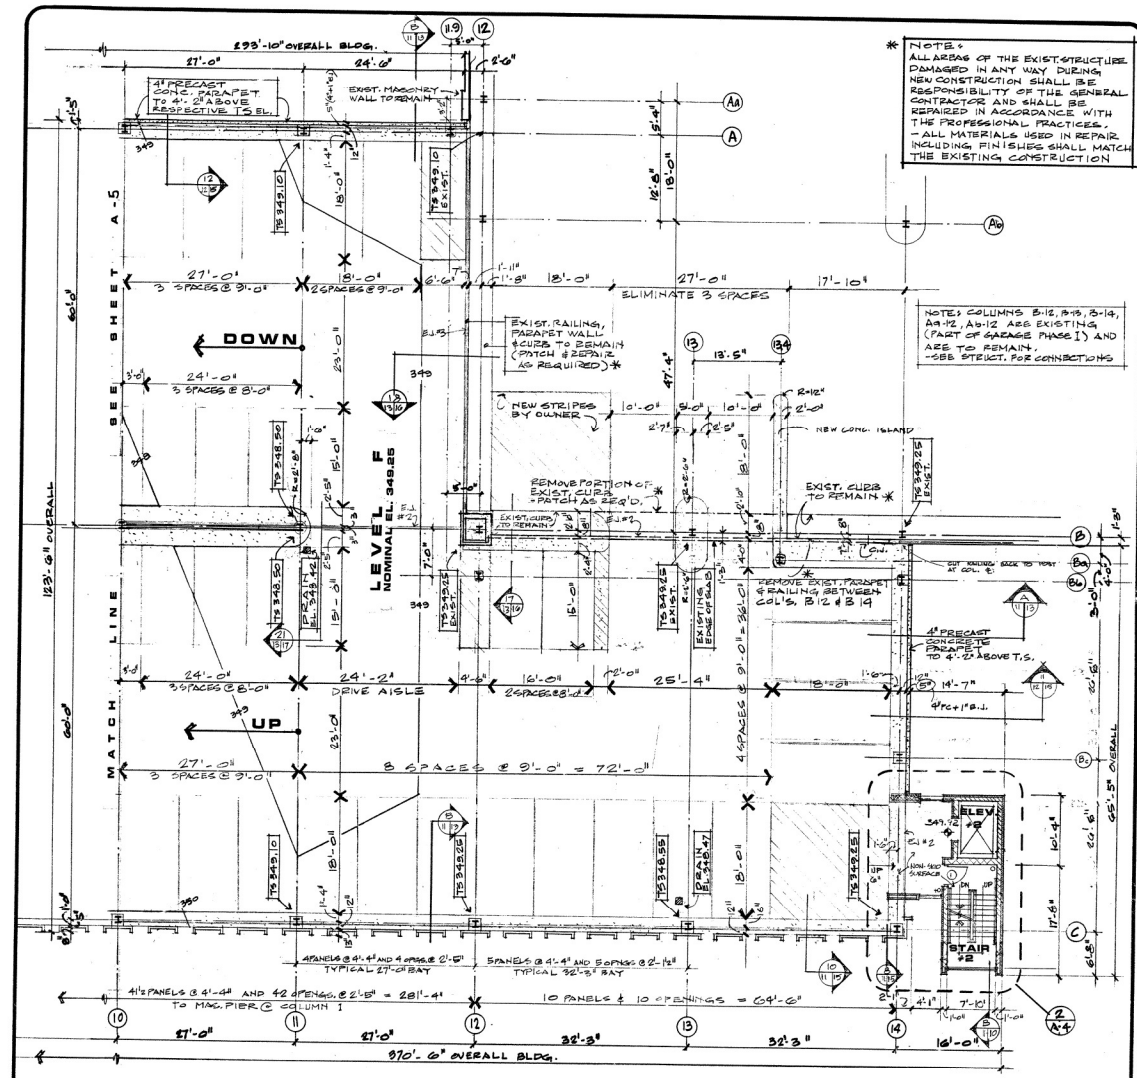

NOTE:
ALL AREAS OF THE EXIST. STRUCTURE DAMAGED IN ANY WAY DURING NEW CONSTRUCTION SHALL BE RESPONSIBILITY OF THE GENERAL CONTRACTOR AND SHALL BE REPAIRED IN ACCORDANCE WITH THE PROFESSIONAL PRACTICES.
- ALL MATERIALS USED IN REPAIR, INCLUDING FINISHES SHALL MATCH THE EXISTING CONSTRUCTION

NOTE: COLUMNS B-12, B-13, B-14, A9-12, A5-12 ARE EXISTING (PART OF GARAGE PHASE I) AND ARE TO REMAIN.
-SEE STRUCT. FOR CONNECTIONS

LEVEL F 1/8"=1'-0"

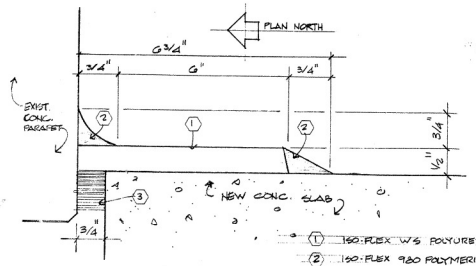

① 150-FLEX W/S POLYURETHANE SEAL
② 150-FLEX 980 POLYMERIC NOSING
③ COMPRESSABLE FILLER

EXPANSION JOINT #3 NO SCALE

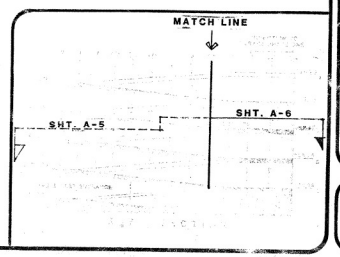

LEWIS BOUQUET
ARCHITECTS AND PLANNERS
7375 WISCONSIN AVE., BETHESDA, MD. 301 657 0800

Meyer Associates
Structural Engineers

SILVER SPRING GARAGE #2, PHASE II
DEPARTMENT OF TRANSPORTATION, DIVISION OF PARKING

J10405
A-6

8/12/92

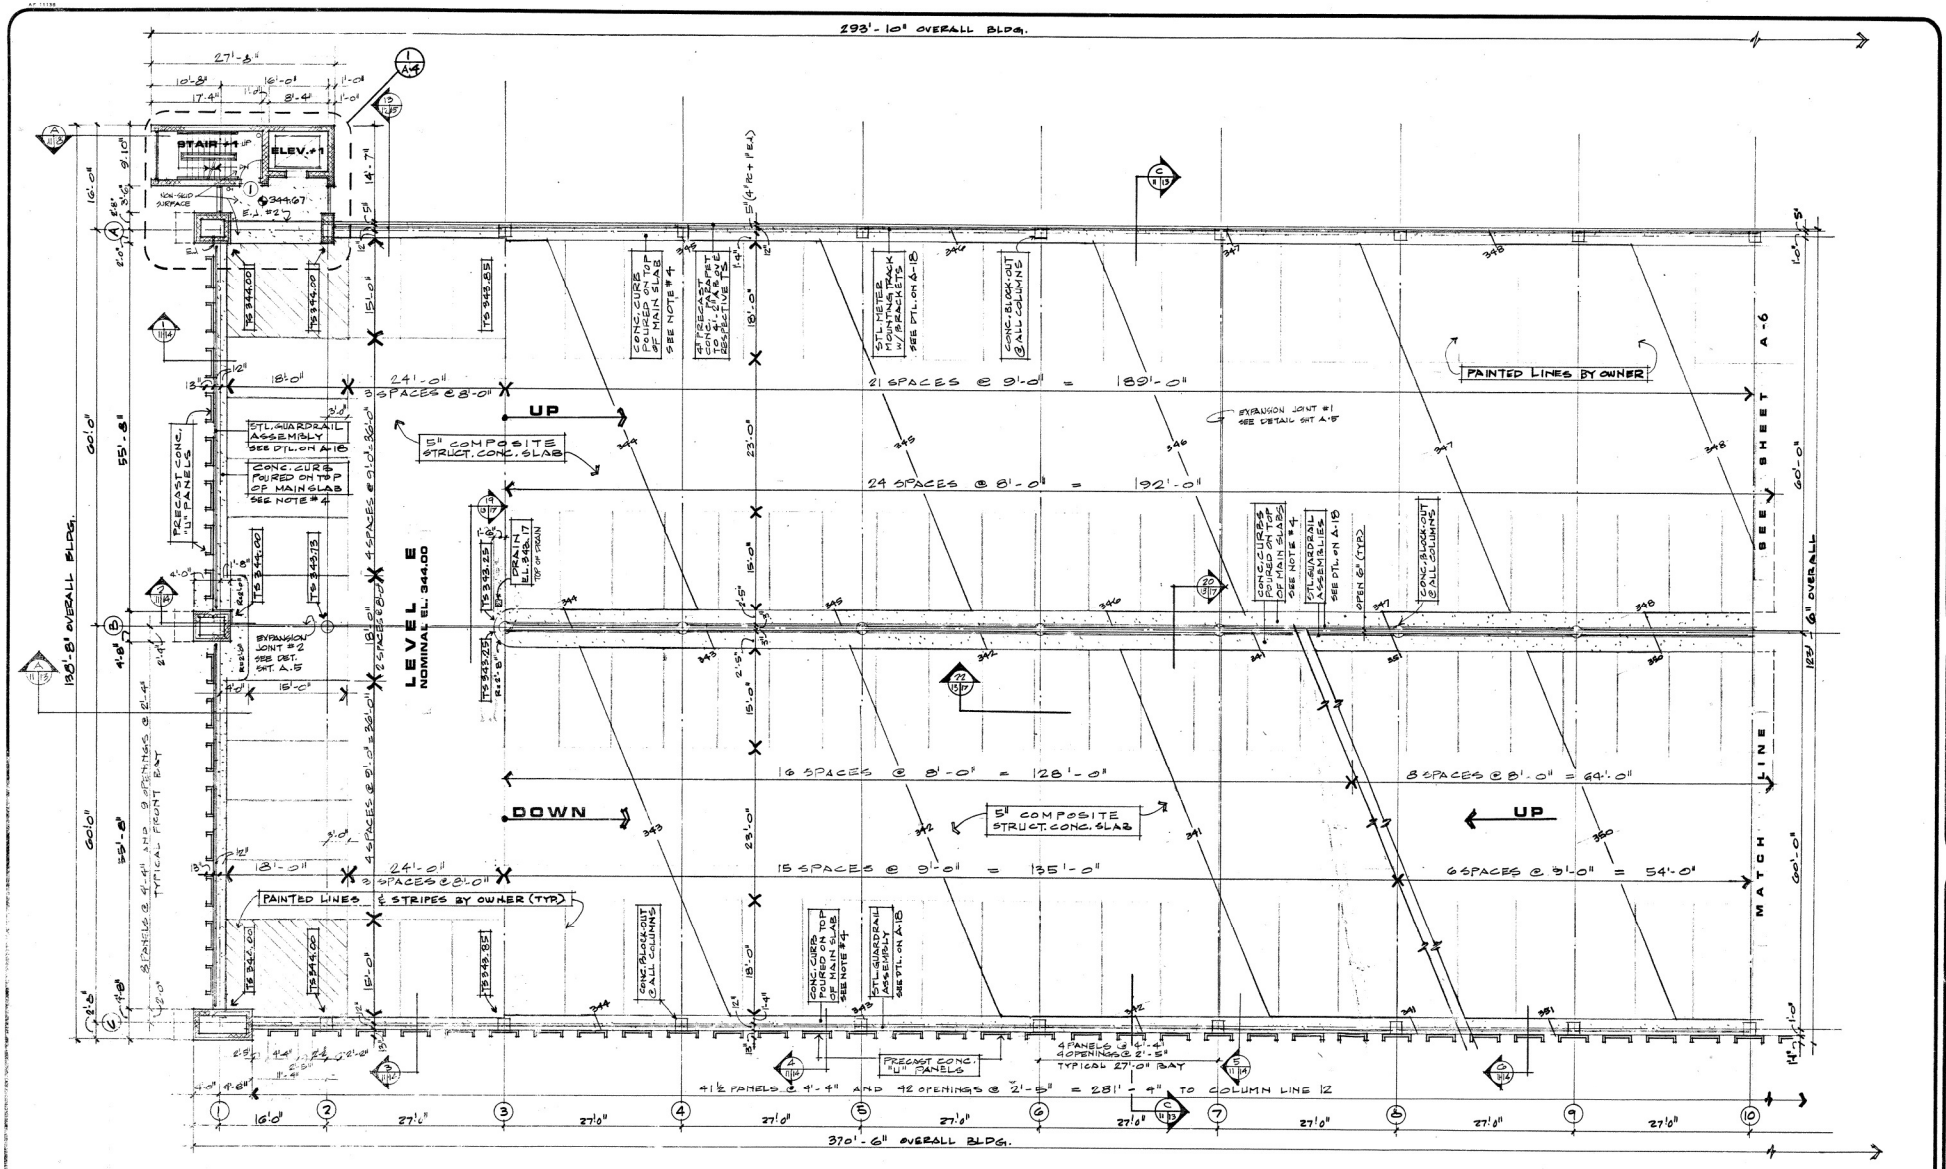

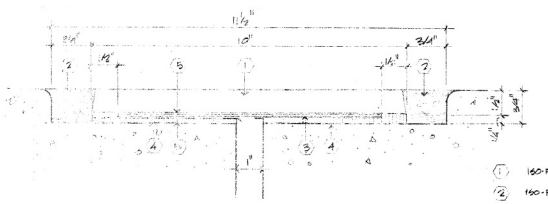

EXPANSION JOINT #1 NO SCALE

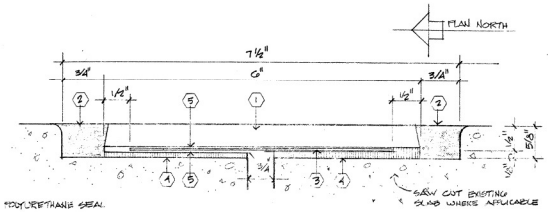

EXPANSION JOINT #2 NO SCALE

1. 150-PLEX POLYURETHANE SEAL
2. 150-PLEX POLYMERIC NOSING
3. ALUM. TRAFFIC SUPPORT PLATE
4. 150-PLEX POLYURETHANE BEDDING
5. BOND BREAKER

NOTE: ALL OTHER EXPANSION JOINTS TO BE FILLED W/PREMOULDED FILLER & CAULKED WATERTIGHT

LEVEL E 1/8"=1'-0"

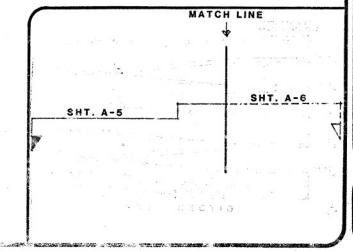

LEWIS BOUQUET
ARCHITECTS AND PLANNERS
7316 WISCONSIN AVE. BETHESDA, MD. 301 657-8800

Meyer Associates
Structural Engineers

SILVER SPRING GARAGE #2, PHASE II
DEPARTMENT OF TRANSPORTATION, DIVISION OF PARKING

J10405

A-5

7/23/82
8/13/81
9/11/81

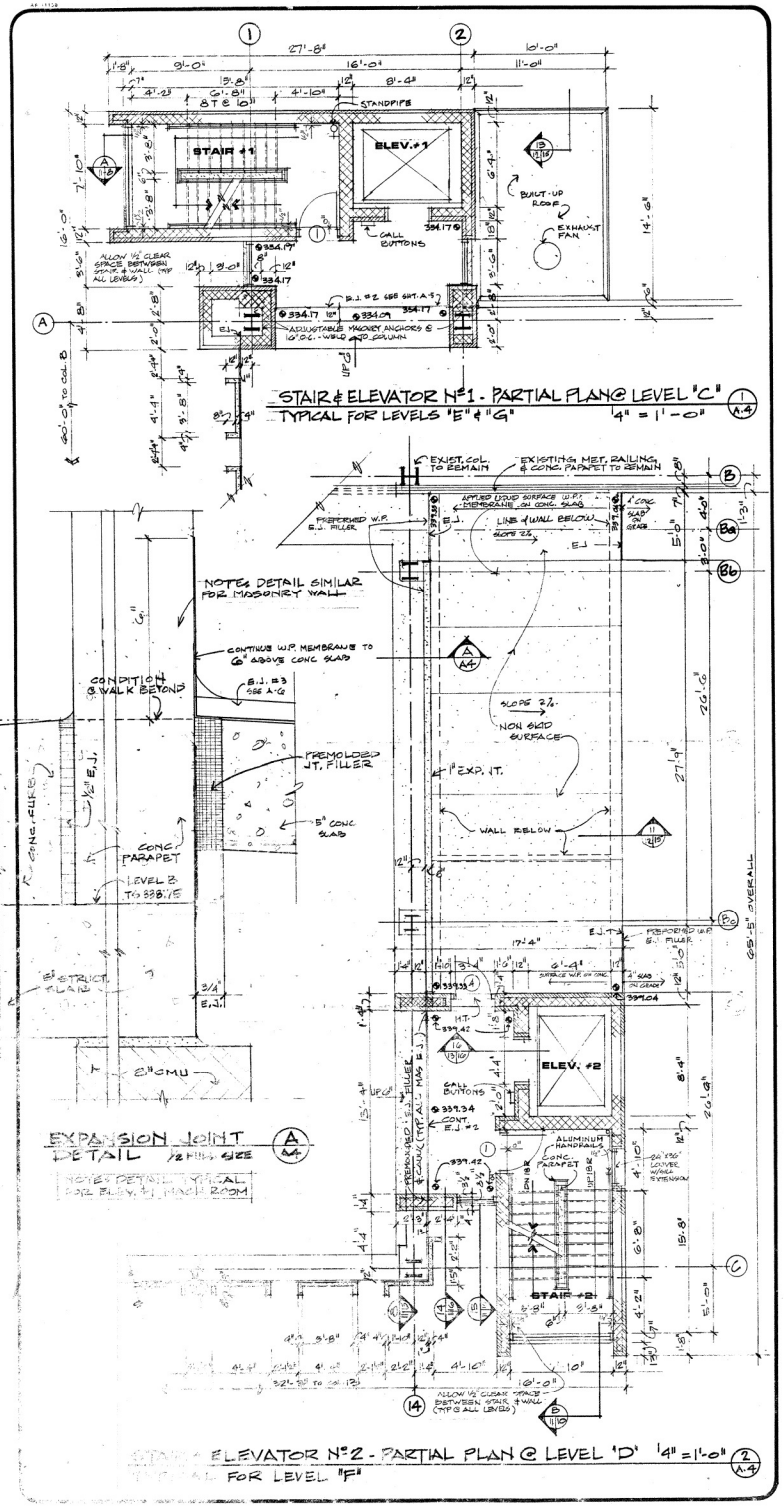

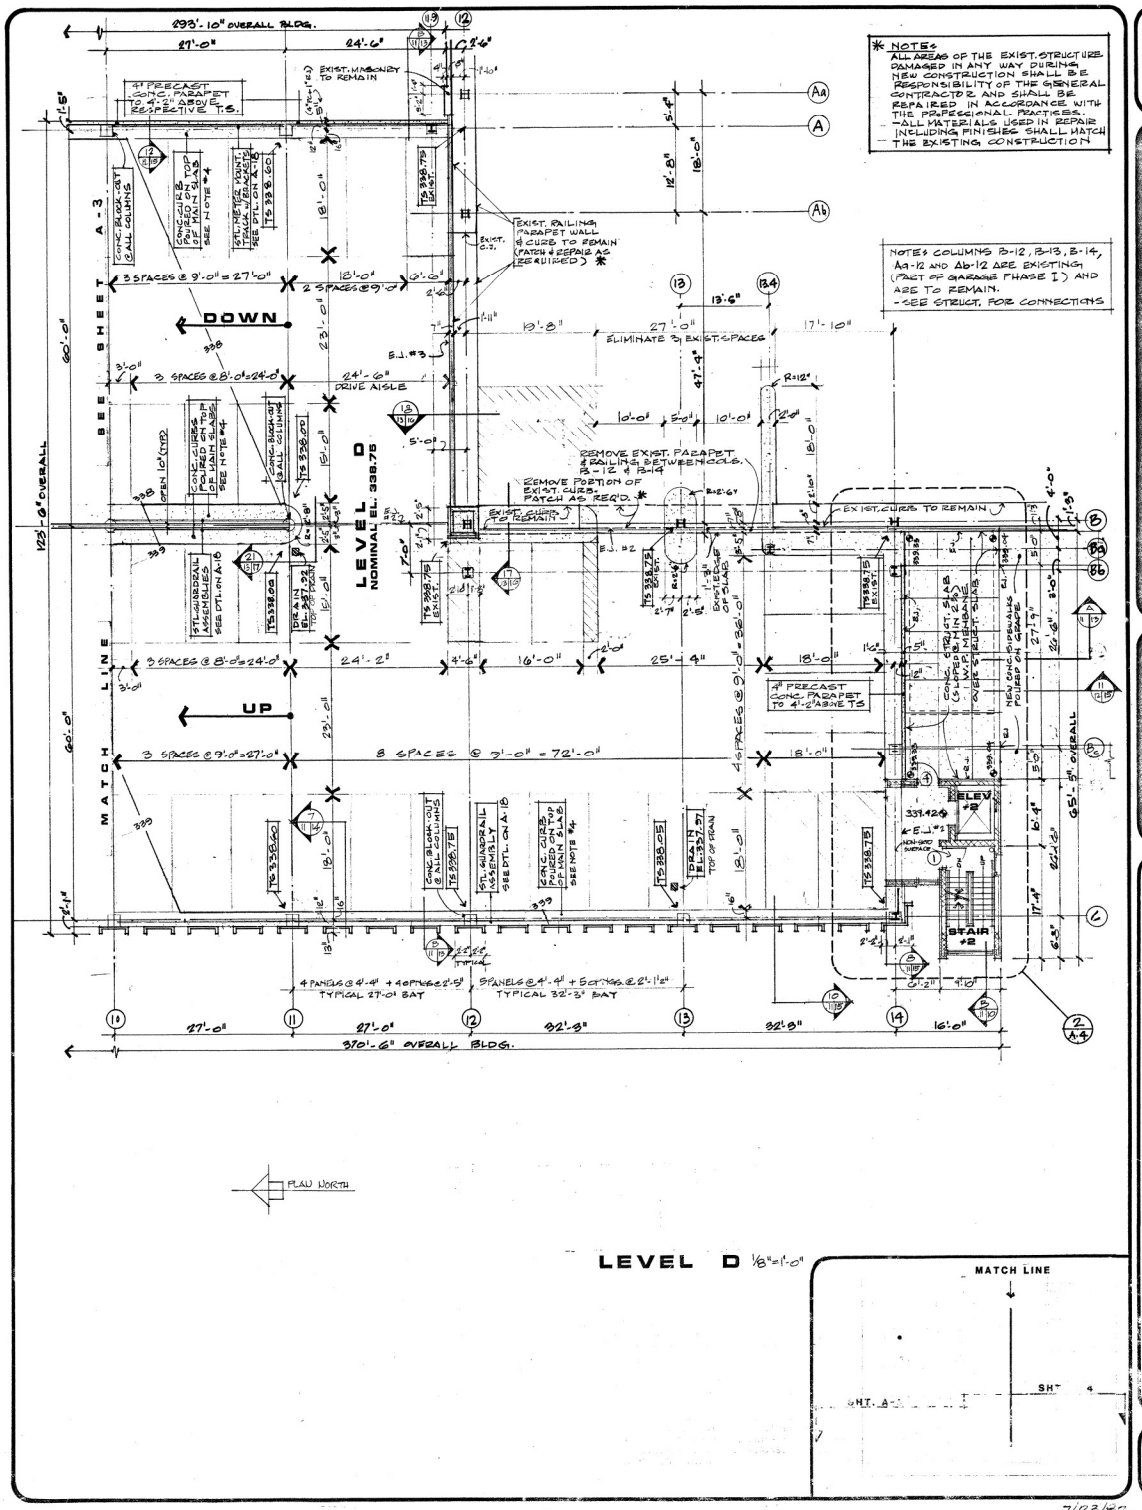

* NOTES
ALL AREAS OF THE EXIST. STRUCTURE DAMAGED IN ANY WAY DURING NEW CONSTRUCTION SHALL BE RESPONSIBILITY OF THE GENERAL CONTRACTOR AND SHALL BE REPAIRED IN ACCORDANCE WITH THE PROFESSIONAL PRACTICES.
- ALL MATERIALS USED IN REPAIR INCLUDING FINISHES SHALL MATCH THE EXISTING CONSTRUCTION

NOTES COLUMNS B-12, B-13, B-14, Aa-12 AND Ab-12 ARE EXISTING (PART OF GARAGE PHASE I) AND ARE TO REMAIN.
- SEE STRUCT. FOR CONNECTIONS

LEWIS / GOUGHEY
ARCHITECTS AND PLANNERS
2315 WISCONSIN AVE. BETHESDA, MD. 301-657-9800

Meyer Associates
Structural Engineers

SILVER SPRING GARAGE #2, PHASE II
DEPARTMENT OF TRANSPORTATION, DIVISION OF PARKING

J10405
A-4

7/23/82
5/20/83
8/13/81
9/11/81

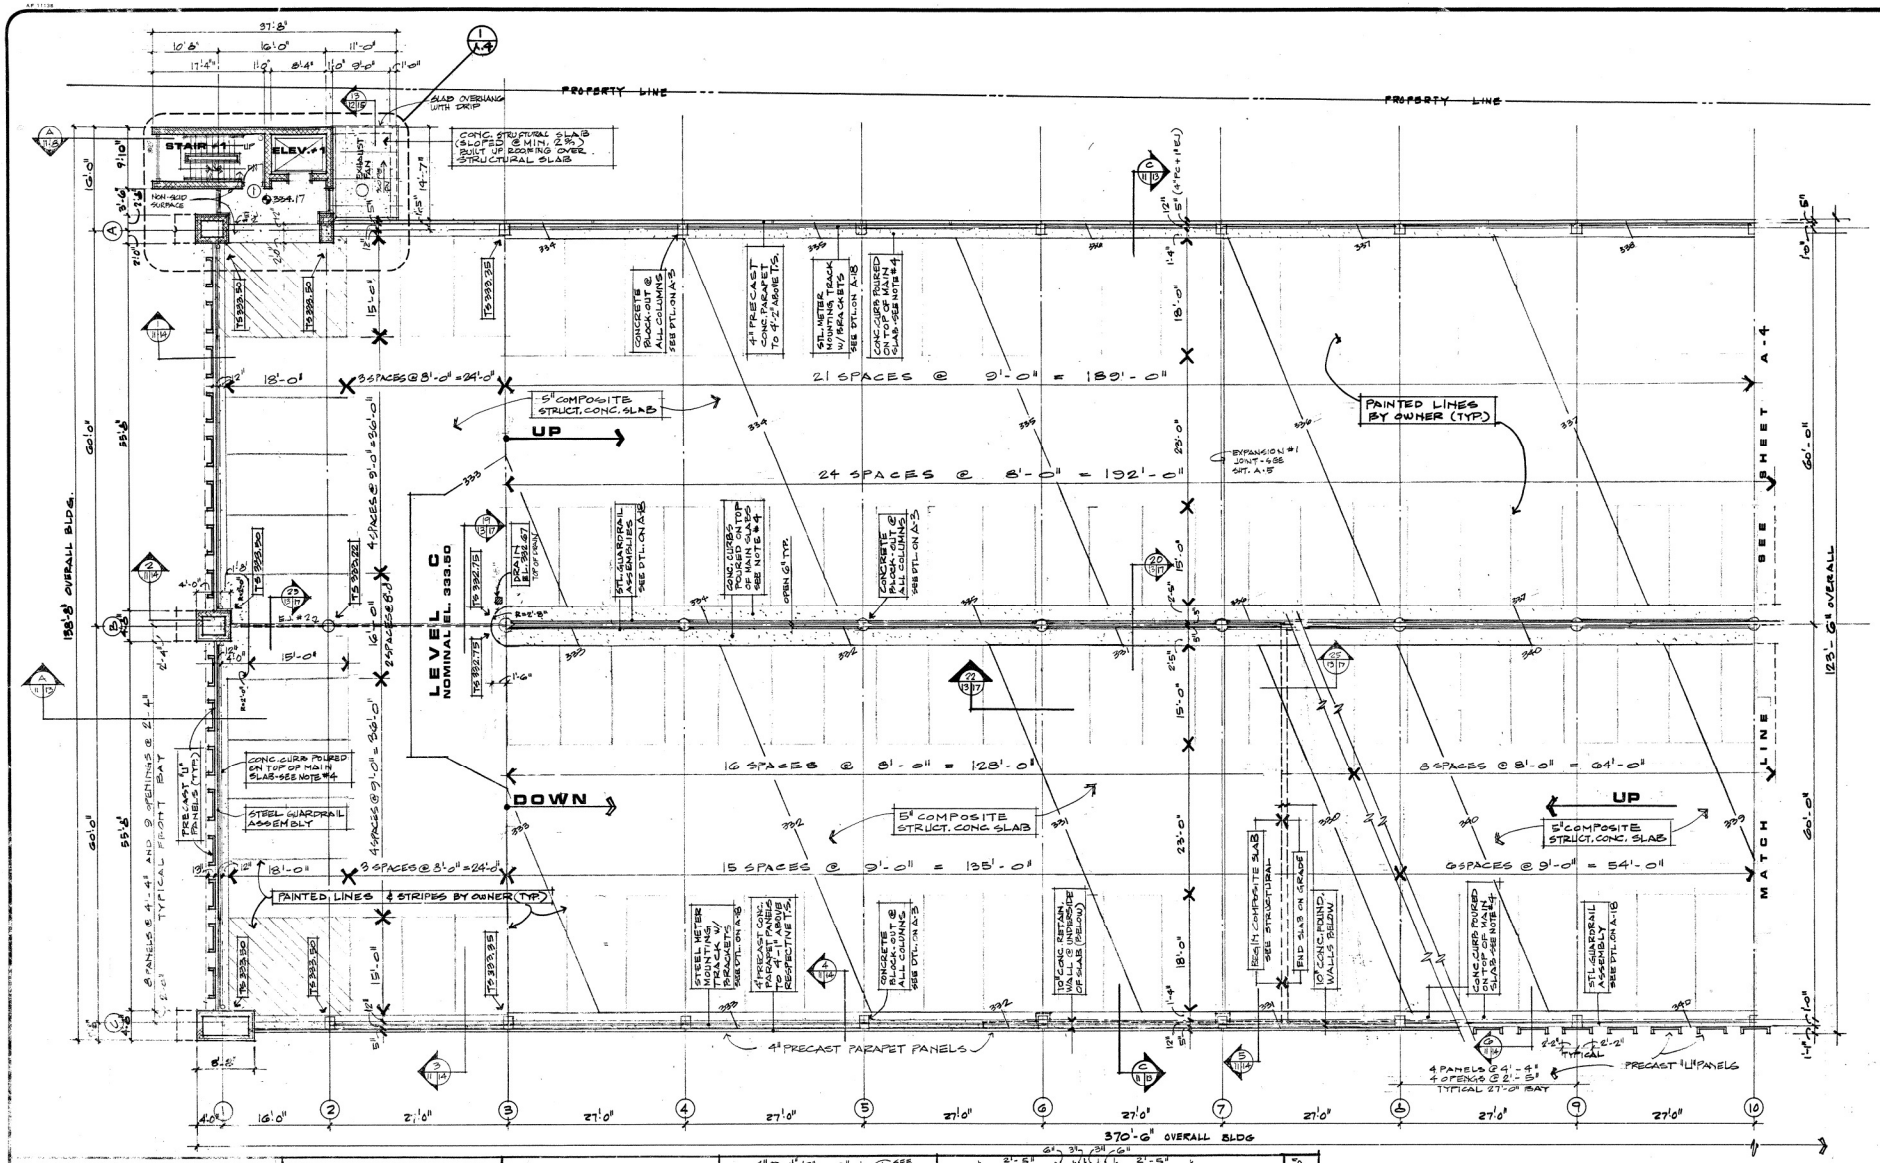

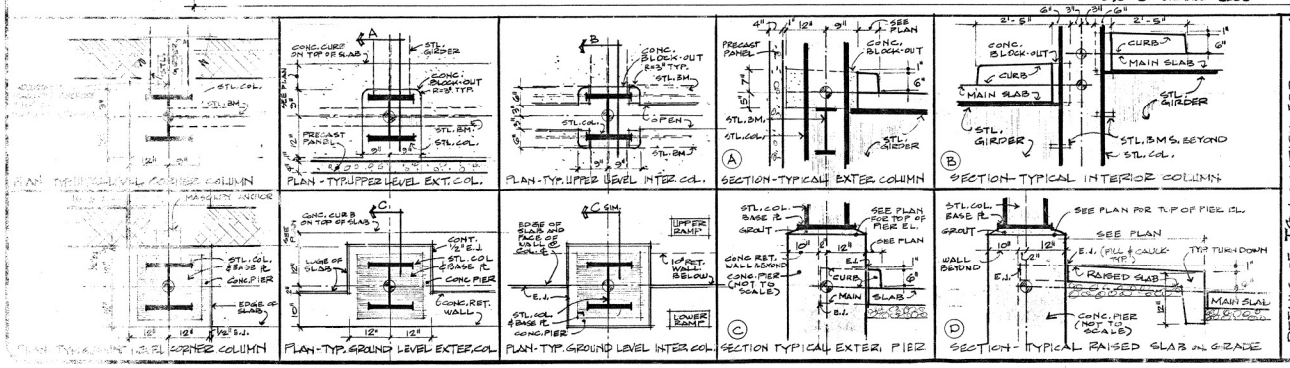

PLAN NORTH

LEVEL C 1/8"=1'-0"

1. FIN. GRADE CONTOURS ARE SHOWN FOR CLARIFICATION PURPOSES ONLY AND SHALL NOT BE USED IN CONSTRUCTION.
2. ACTUAL FIN. GRADES OF PARKING LEVELS AND RAMPS SHALL BE ESTABLISHED BY CRITICAL TOP OF SLAB (TS) ELEVATIONS ASSUMED AT CENTER OF COLUMNS. (SEE DETAILS ON DWG. A-3)
3. FIN. GRADES OF STAIR/ELEVATOR LANDINGS SHALL BE ESTABLISHED BY SPOT ELEVATIONS WITH SYMBOL
4. UNLESS SHOWN OTHERWISE, ALL INTERIOR CURBS SHALL BE POURED ON TOP OF MAIN CONCRETE SLABS AT +6" (FRONT) AND +3" (BACK) ABOVE RESPECTIVE TS ELEVATIONS. (SEE DETAILS ON DWG. A-3)

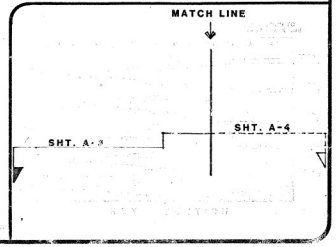

LEWIS/BOUQUET ARCHITECTS AND PLANNERS
7316 WISCONSIN AVE. BETHESDA, MD. 301 657-8800

Meyer Associates Structural Engineers

SILVER SPRING GARAGE #2, PHASE II
DEPARTMENT OF TRANSPORTATION, DIVISION OF PARKING

J10405

A-3

9/11/81

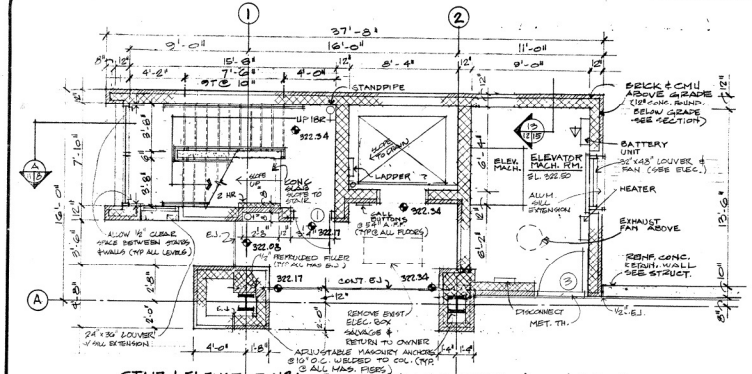

STAIR & ELEVATOR Nº 1 - PARTIAL PLAN @ LEVEL A 1/4" = 1'-0"

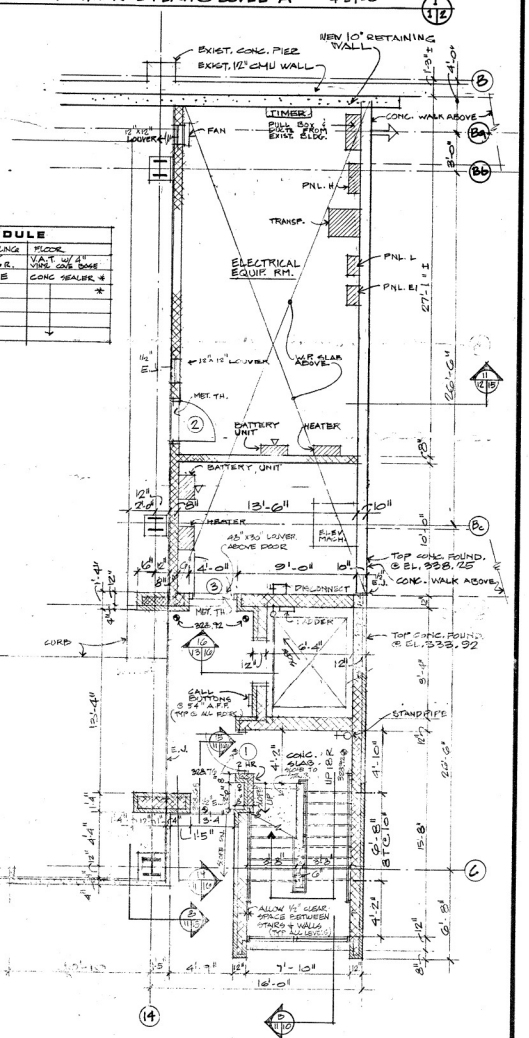

FINISH SCHEDULE			
	WALLS	CEILINGS	FLOOR
ELEVATOR #1 & #2	BY MFGR.	BY MFG R.	VAT W/ 4" VINE COVE BASE
STAIR #1	PAINT	NONE	CONC SEALER *
STAIR #2			*
ELEV. MACH. RM. #1			
ELEV. MACH. RM. #2			
ELEC. EQUIP. RM.			

* PROVIDE NON-SKID SURFACE

STAIR & ELEVATOR Nº 2 - PARTIAL PLAN @ LEVEL B 1/4" = 1'-0"
[illegible] JACK + JACK HOLE TO PROVIDE FOR FUTURE ADDITIONAL LEVEL ELEVATOR #2 ONLY

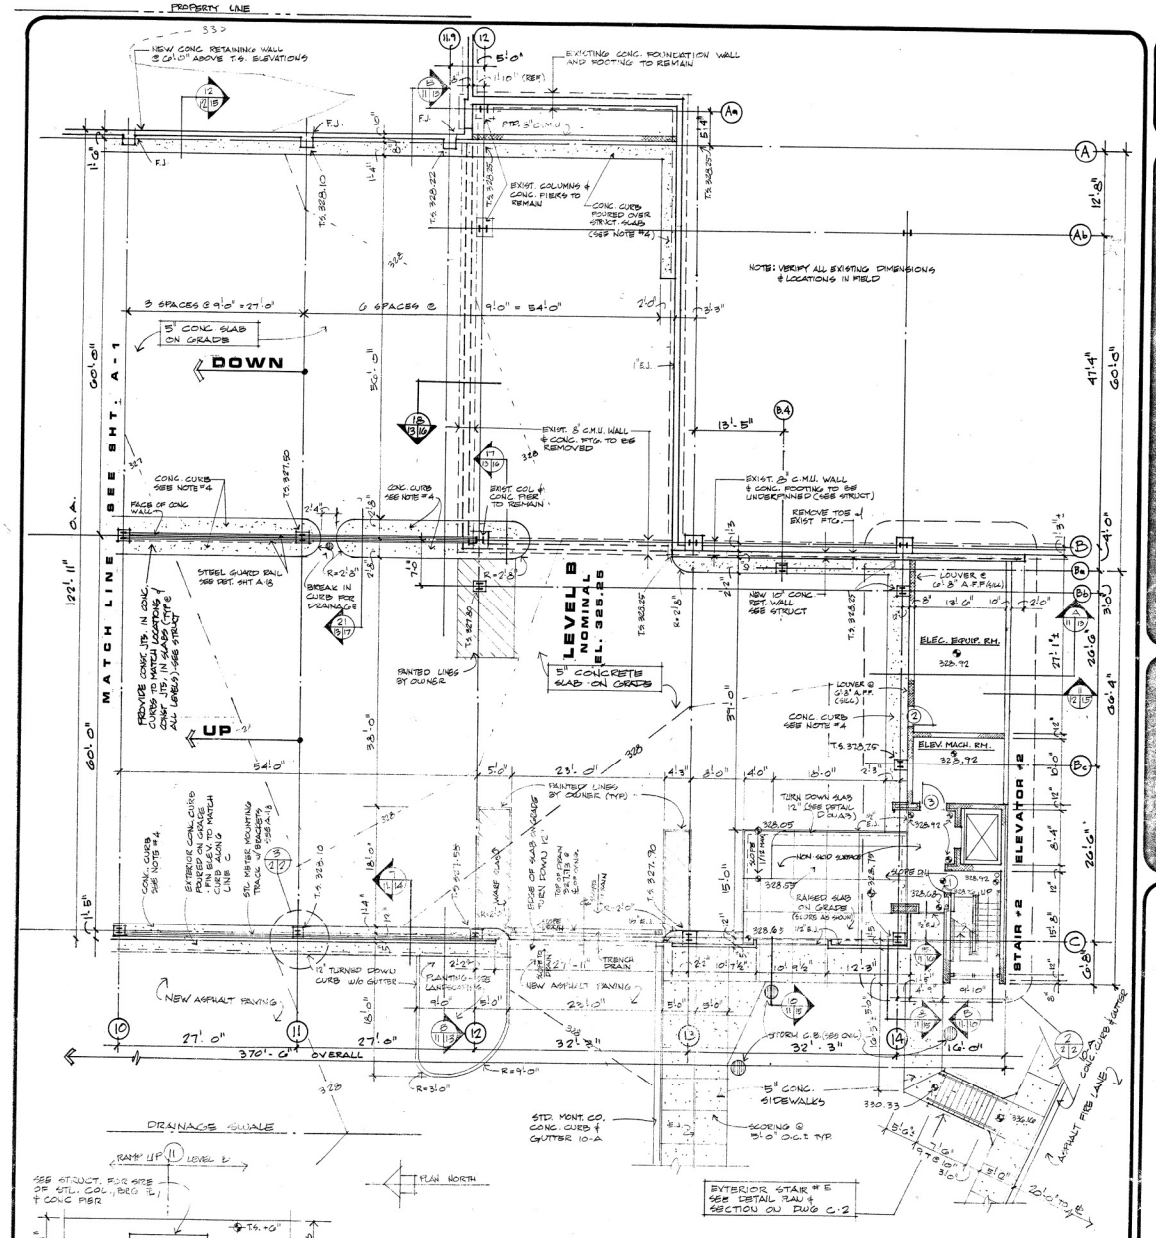

PLAN DETAIL 3/4" = 1'-0"

LEVEL B 1/8" = 1'-0"

MATCH LINE

SHT. A-1 SHT. A-2

LEWIS / BOUQUET
ARCHITECTS AND PLANNERS
7316 WISCONSIN AVE., BETHESDA, MD. 301 652 8800

Meyer Associates
Structural Engineers

SILVER SPRING GARAGE #2, PHASE II
DEPARTMENT OF TRANSPORTATION, DIVISION OF PARKING

J10405

A-2

REV 1 OCT 87

5/20/83

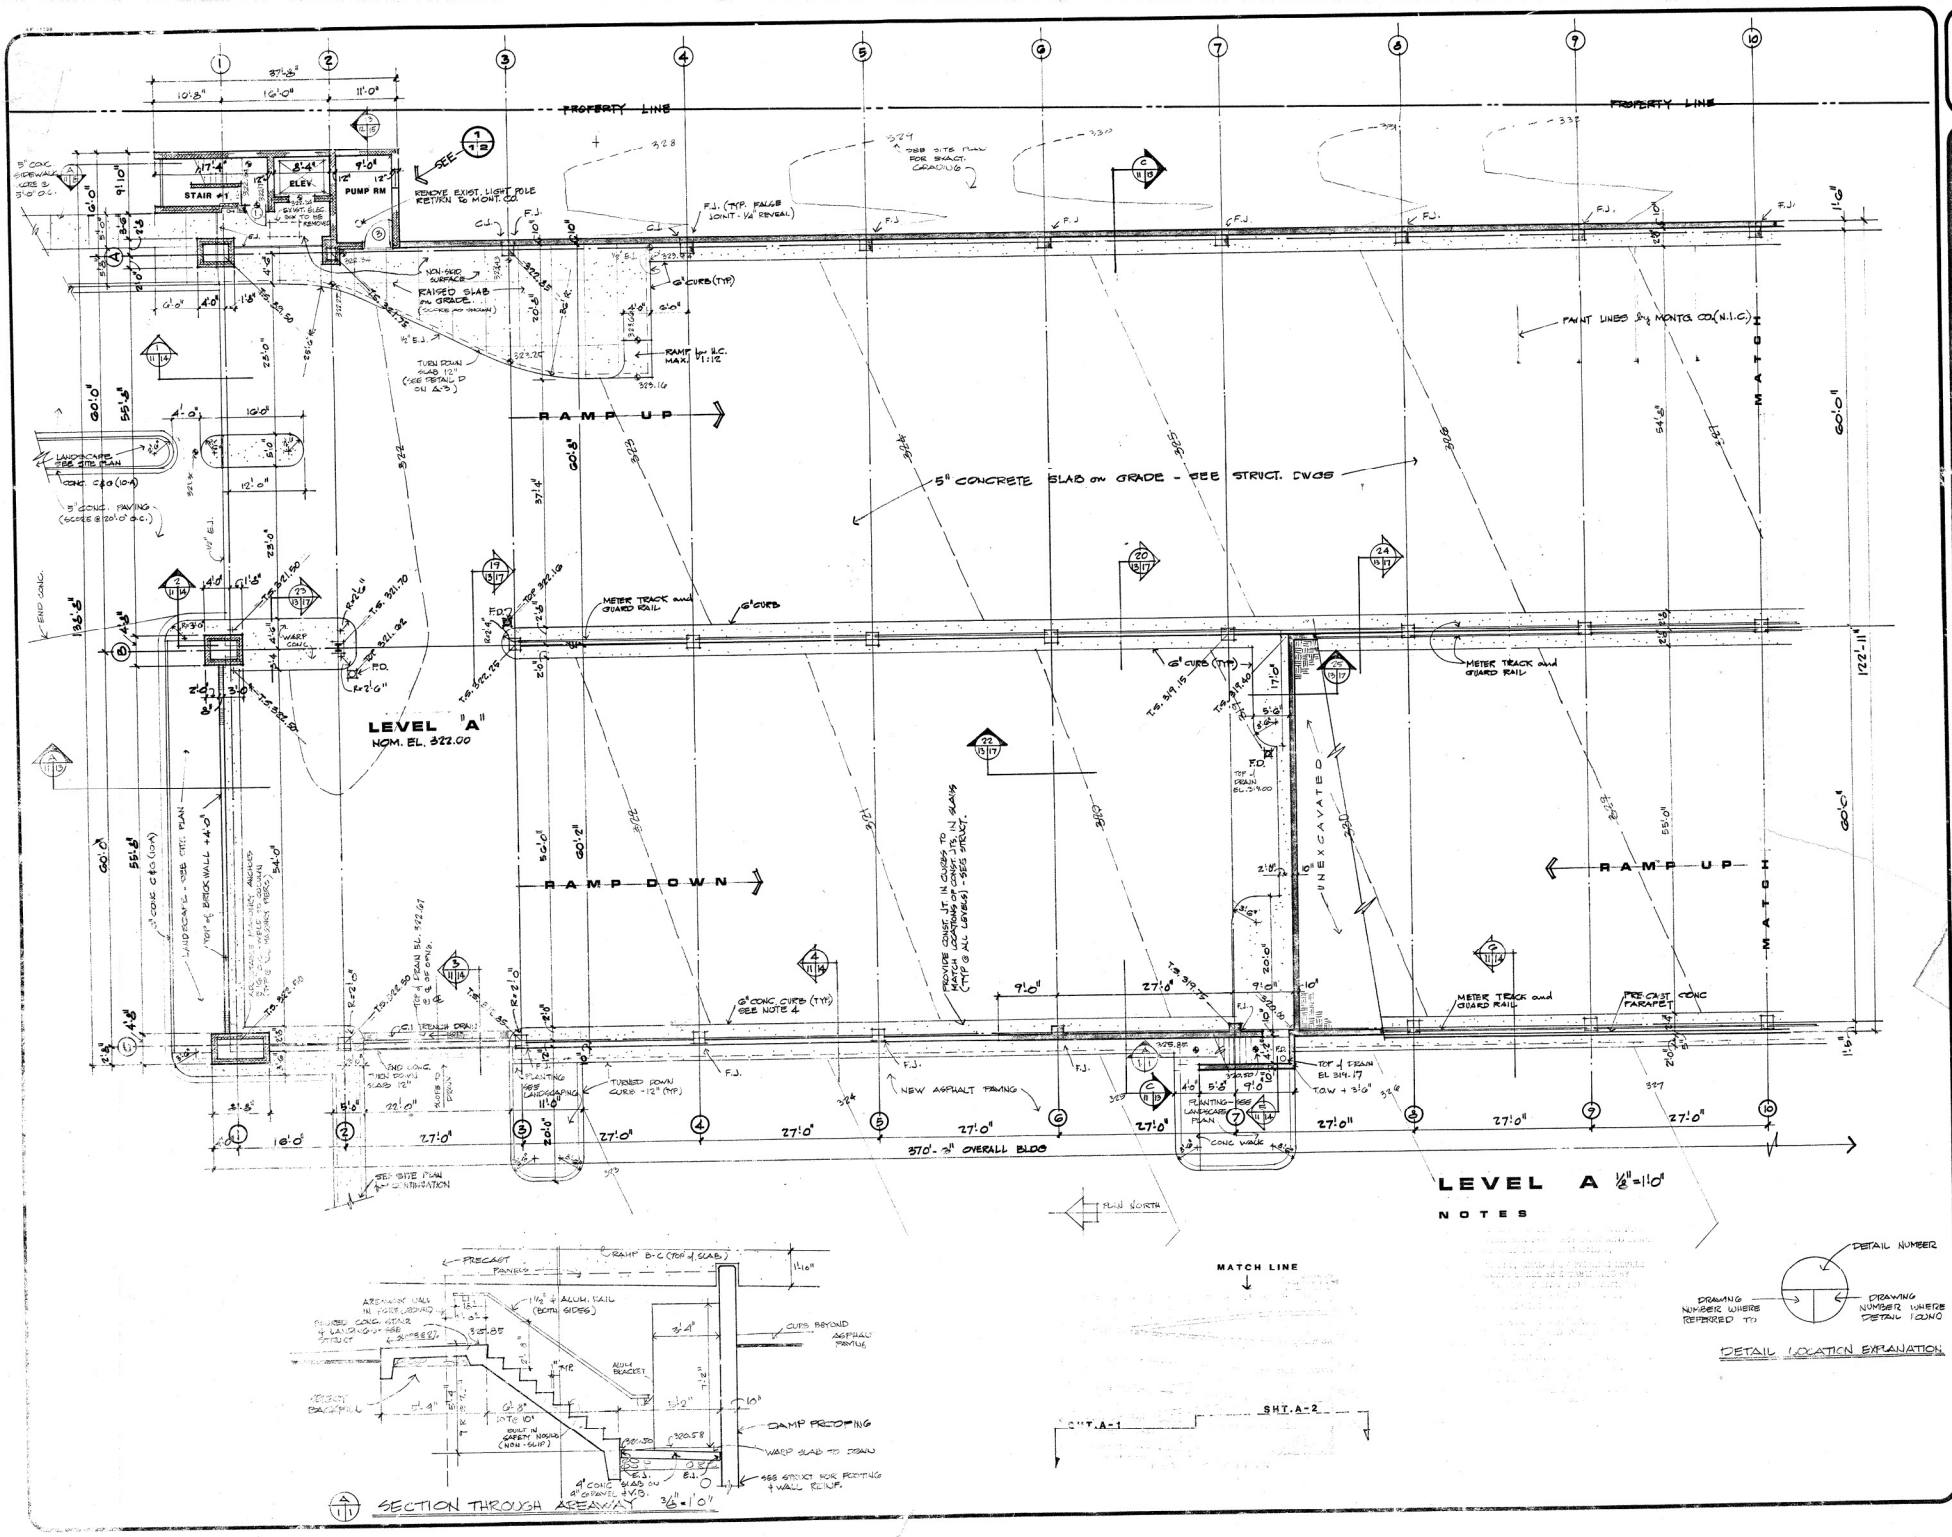

LEWIS BOUQUET
ARCHITECTS AND PLANNERS
7315 WISCONSIN AVE. BETHESDA, MD. 301-657-9800

Meyer Associates
Structural Engineers

SILVER SPRING GARAGE #2, PHASE II
DEPARTMENT OF TRANSPORTATION, DIVISION OF PARKING

J10405
A-1
REV. 1 OCT. 82

5/20/83
6/30/83

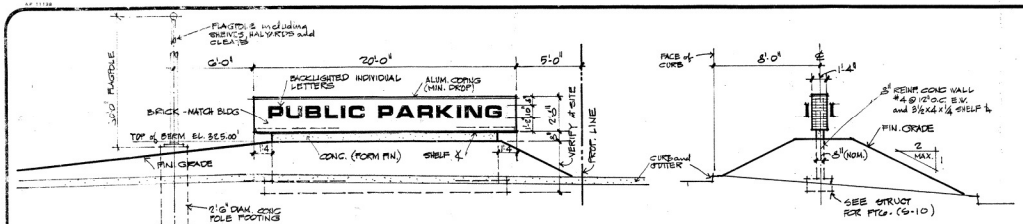

BUILDING SIGN at SPRING STREET ¼"=1'-0"

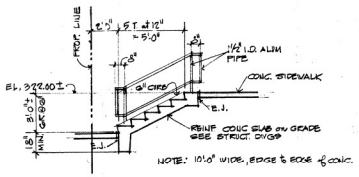

STAIR #4 ¼"=1'-0"

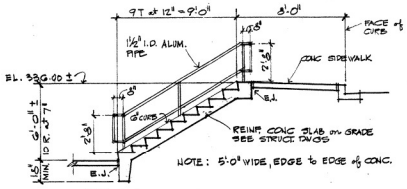

STAIR #5 ¼"=1'-0"

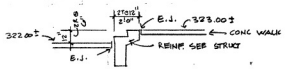

STAIR #6 ¼"=1'-0"

NOTE: ALL STAIRS SHALL CONFORM TO ADOPTED CODE (1978 BOCA) AND LOCAL AMENDMENTS

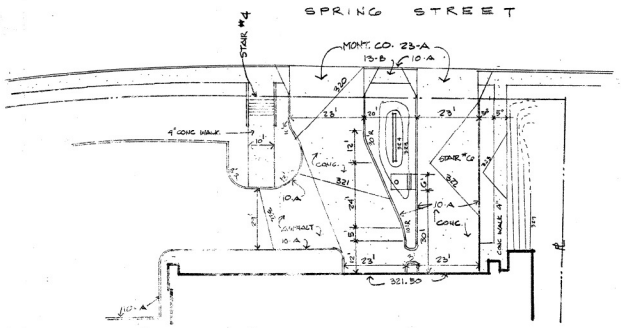

NORTH ENTRANCE DETAIL 1"=20'-0"

FOR INFORMATION NOT SHOWN SEE SITE PLAN THIS SHT. OR A-1

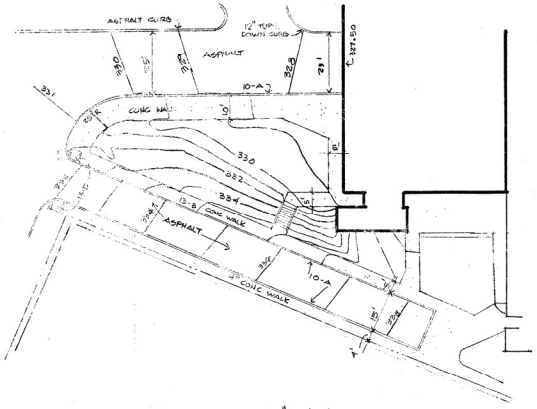

SOUTH ENTRANCE DETAIL 1"=20'-0"

FOR INFORMATION NOT SHOWN SEE SITE PLAN THIS SHEET OR A-2

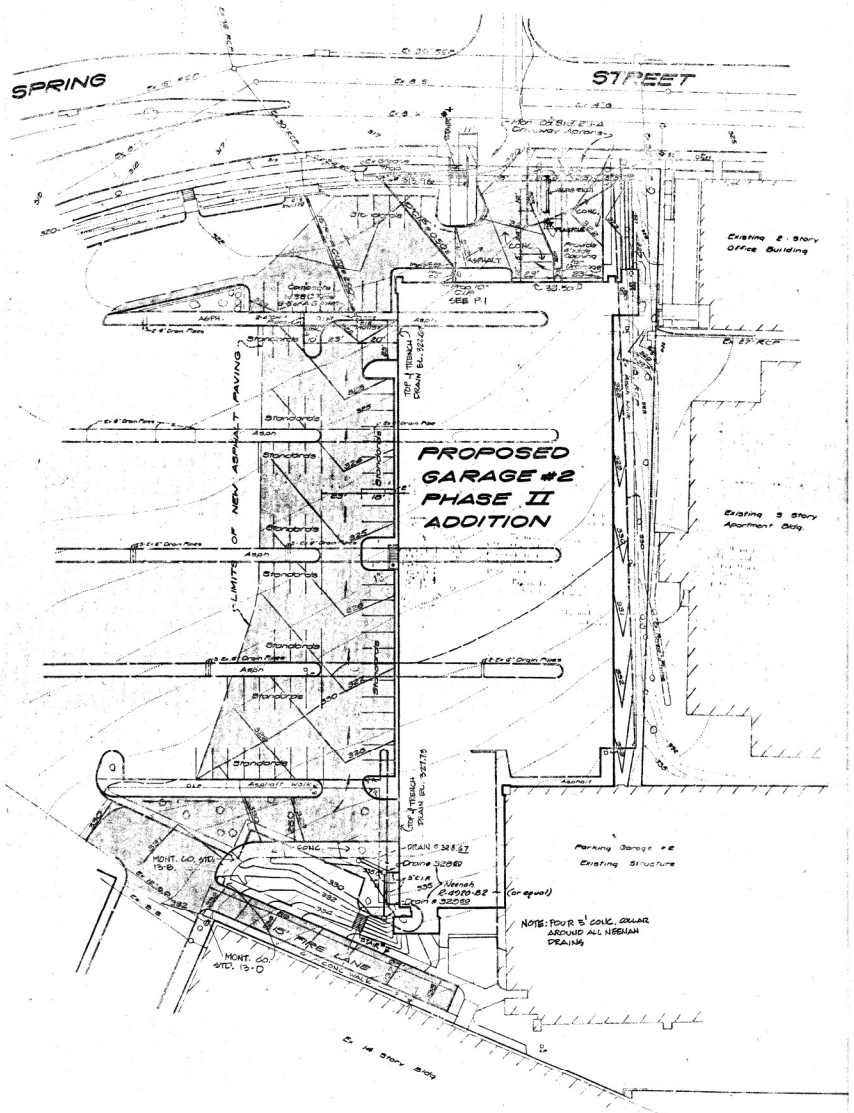

SITE ENGINEERING PLAN

SCALE: 1"=30'

FOR LANDSCAPING SEE C-3

LEWIS ARCHITECTS AND PLANNERS

Meyer Associates Structural Engineers

SILVER SPRING GARAGE #2, PHASE II

DEPARTMENT OF TRANSPORTATION, DIVISION OF PARKING

J10405

C-2

5/20/83
6/30/83

PUBLIC PARKING GARAGE Nº 2

CAMERON STREET SILVER SPRING MARYLAND

MONTGOMERY COUNTY GOVERNMENT
DEPARTMENT OF PUBLIC WORKS
BUREAU OF PARKING

CLAS RIGGS OWENS & RAMOS
1015 TWIN TOWERS SILVER SPRING, MARYLAND 20910
Architects

H. ALLISON & R. L. MEYER
121 CONGRESSIONAL LANE ROCKVILLE, MARYLAND 20852
Structural Engineers

J. B. WYBLE & ASSOCIATES
7950 NORFOLK AVENUE BETHESDA, MARYLAND 20014
Mechanical & Electrical Engineers

JAMES P. GLEASON
County Executive

JOSEPH C. KORDELLA
Director of Public Works

LIST OF DRAWINGS

ARCHITECTURAL

C-S	COVER SHEET
A-1	TOPOGRAPHIC SURVEY OF SITE, CONSTRUCTION FENCE LOCATION PLAN & SYMBOLS
A-2	SITE PLAN & LANDSCAPING PLANS
A-3	FLOOR PLAN LEVEL L-1
A-4	FLOOR PLAN LEVELS L-2 AND L-3
A-5	FLOOR PLAN LEVELS L-4 AND L-5
A-6	FLOOR PLAN LEVELS L-6, L-8 AND L-7, L-9
A-7	FLOOR PLAN LEVELS L-10 AND L-11
A-8	FLOOR PLAN LEVEL L-12, DOOR SCHEDULE & DETAILS
A-9	ELEVATIONS & PLANTERS' ELEVATIONS
A-10	ELEVATIONS & SECTION
A-11	MINIPARK PLAN & DETAIL - OFFICE PLAN, ELEVATIONS AND DETAILS
A-12	STAIR NO. 1 AND NO. 2
A-13	STAIR DETAILS, WINDOW ELEVATIONS & DETAILS
A-14	WALL SECTIONS
A-15	WALL SECTIONS
A-16	WALL AND WINDOW SECTIONS

STRUCTURAL

S-1	BORING LOGS & CONSTRUCTION JOINT PLAN & DETAILS
S-2	FOUNDATION PLAN
S-3	LEVELS L-2 AND L-4 FRAMING PLAN
S-4	TYPICAL LEVEL FRAMING PLAN
S-5	ROOF FRAMING PLAN
S-6	STAIR TOWER PLANS & DETAILS
S-7	COLUMNS SCHEDULE & DETAILS
S-8	SECTIONS & DETAILS
S-9	NOTES & DETAILS

MECHANICAL AND ELECTRICAL

M-1	PLMG. & ELEC. NOTES - DETAILS & UTILITY SITE PLAN
M-2	PLMG. & MECH. 1ST FLOOR PLAN - LEVELS L-1 AND L-2
M-3	PLMG. - TYPICAL FLOOR PLAN LEVELS L-3 TO L-11 AND MECH. FLOOR PLAN, LEVEL L-8, EQUIP. LIST & NOTES
M-4	PLMG. & MECH. MISC. FLOOR PLANS & DETAILS, PLMG. EQUIP. LIST, SYMBOLS, SCHEDULES & MISER DIAGRAMS
E-1	ELECTRICAL FLOOR PLAN LEVEL L-1
E-2	ELECTRICAL FLOOR PLAN LEVELS L-2 AND L-3
E-3	ELECTRICAL FLOOR PLAN LEVELS L-4 TO L-9
E-4	ELECTRICAL FLOOR PLAN LEVELS L-10 AND L-11
E-5	ELECTRICAL FLOOR PLAN LEVEL L-12 & DETAILS
E-6	ELEC. SYSTEM DIAGRAM, LEGEND, DETAILS, NOTES & DETAILS

THIS BUILDING HAS BEEN DESIGNED IN ACCORDANCE WITH ALL APPLICABLE CODES AND ORDINANCES.

3-15-71
DATE

ANTONIO R. RAMOS REG. 855-A

COVER SHEET | CS

AS BUILT