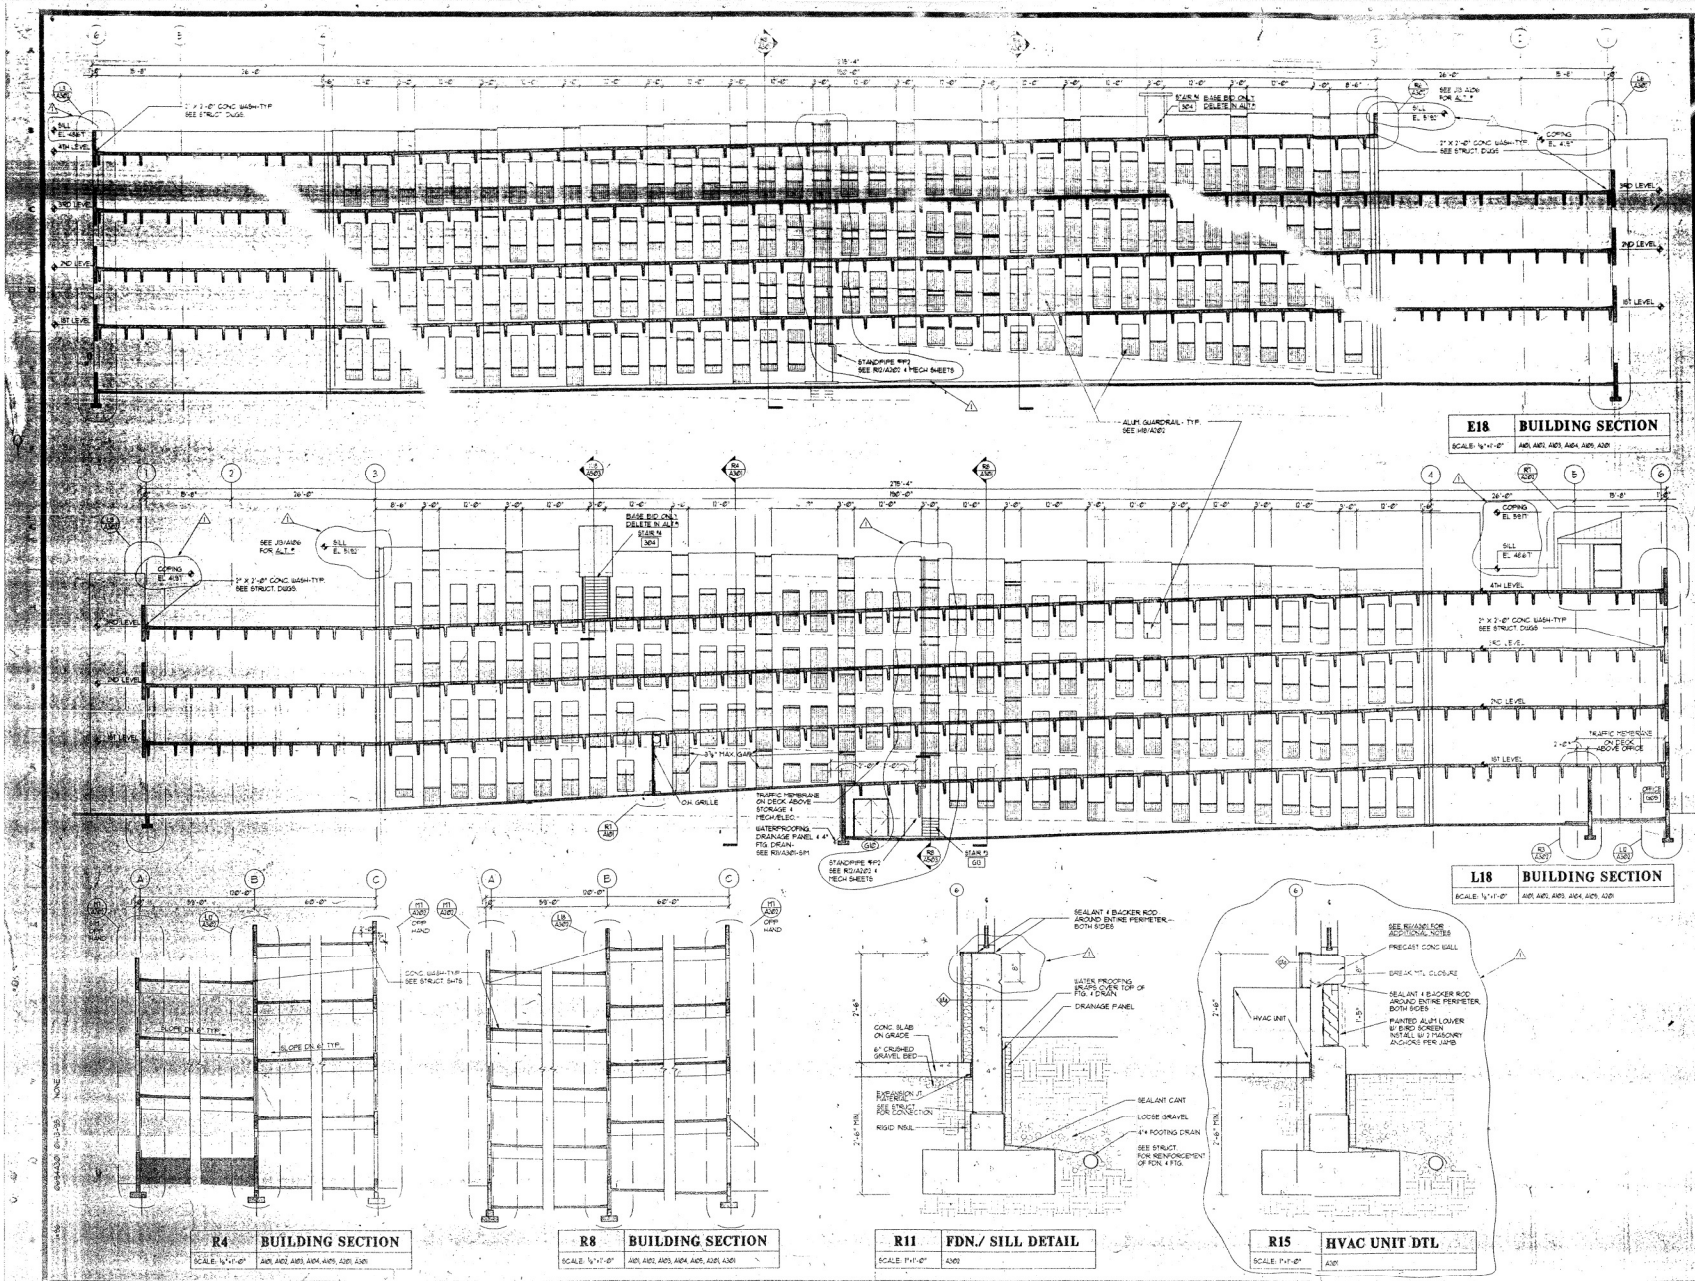

E18	BUILDING SECTION
SCALE: 1/8"=1'-0"	A401, A402, A403, A404, A405, A201

L18	BUILDING SECTION
SCALE: 1/8"=1'-0"	A401, A402, A403, A404, A405, A201

R4	BUILDING SECTION
SCALE: 1/8"=1'-0"	A401, A402, A403, A404, A405, A201, A301

R8	BUILDING SECTION
SCALE: 1/8"=1'-0"	A401, A402, A403, A404, A405, A201, A301

R11	FDN./ SILL DETAIL
SCALE: 1"=1'-0"	A302

R15	HVAC UNIT DTL
SCALE: 1"=1'-0"	A201

REVISION

1 REVISION NO.1

PROJECT NAME

PARKING GARAGE No. 9

MONTGOMERY COUNTY

SHEET TITLE

BUILDING SECTIONS

JOB NUMBER

106-

DATE

12-01-1

SHEET #

A301

10227 WINCOPIN CIRCLE, SUITE 200 COLUMBIA, MD 21044

ARCHITECTS PLANNERS

DEVELOPMENT CONSULTANTS

LBBrasher

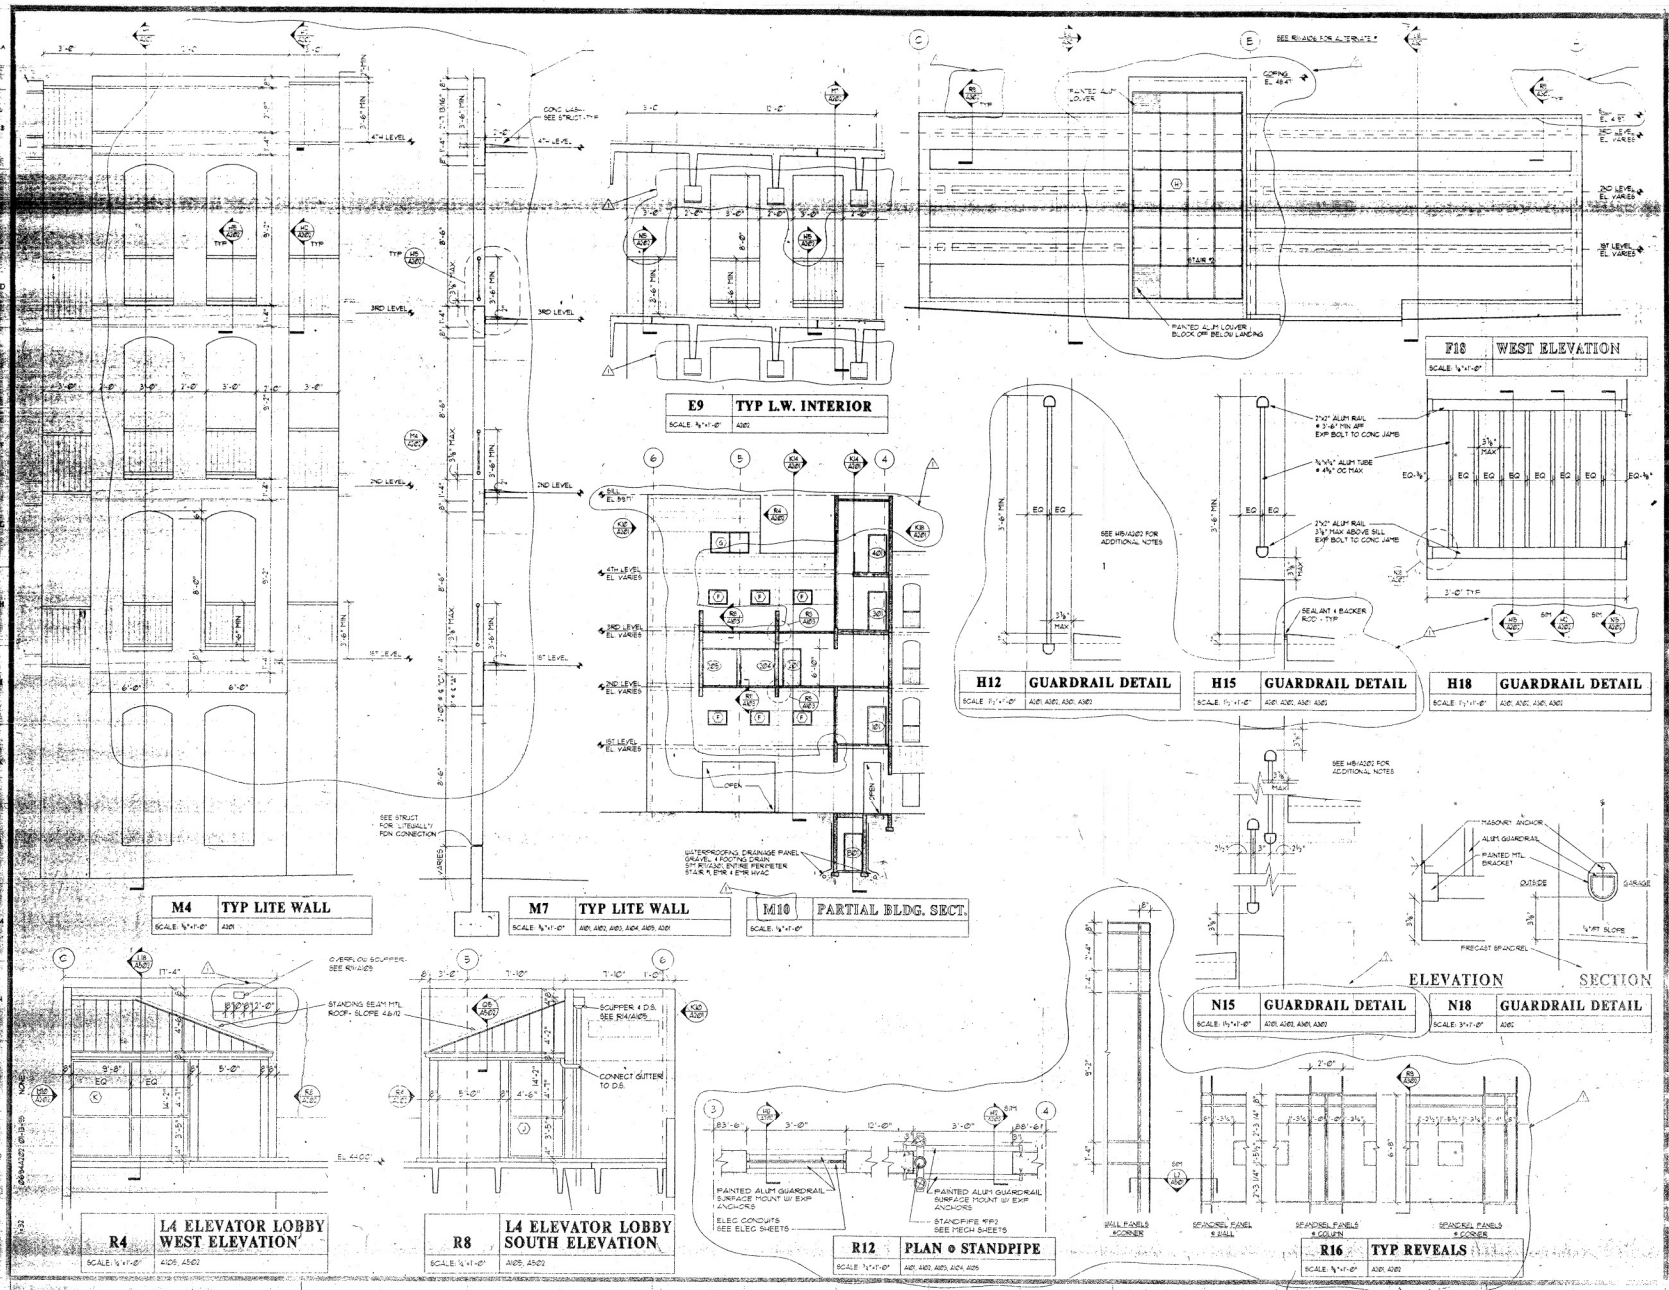

10227 WINCOPIN CIRCLE, SUITE 700, COLUMBIA, MD 21044
BALTO. (410)995-0035 • WASH. D.C./VA. (301)621-0020

DRBrasher

PLANNERS ENGINEERS CONSULTANTS

PARKING GARAGE No. 9
MONTGOMERY, COUNTY

ELEVATION DETAILS

A202

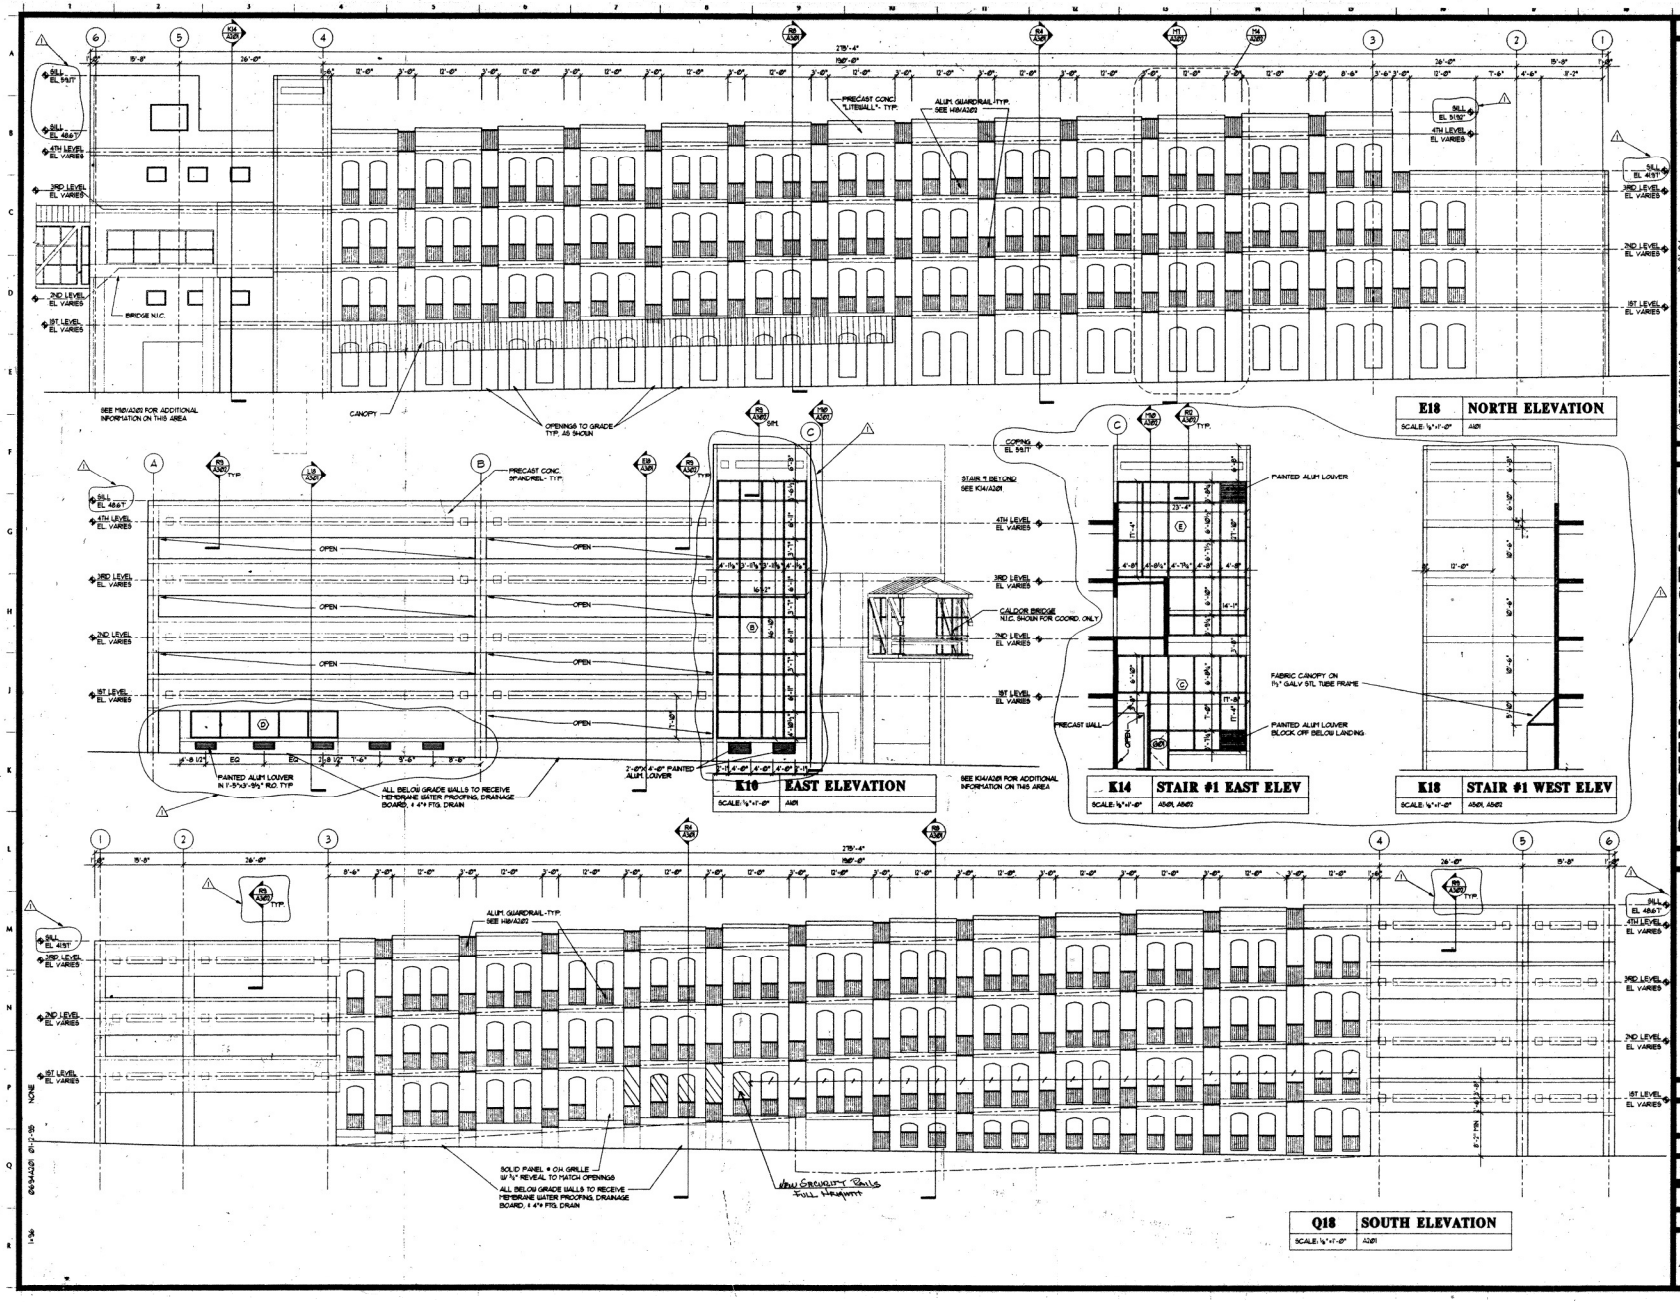

REVISIONS

12-31-94

REVISION NO. 1

PROJECT NAME

PARKING GARAGE No. 9
MONTGOMERY, COUNTY

SHEET TITLE

ELEVATIONS

JOB NUMBER

106-94

DATE

12-01-94

SHEET NUMBER

A201

DRBrasher

ARCHITECTS • PLANNERS
DEVELOPMENT CONSULTANTS

10227 WINCOPIN CIRCLE, SUITE 700 COLUMBIA, MD 21044
BALTO. (410)995-0015 • WASH./VA. (301)321-6020

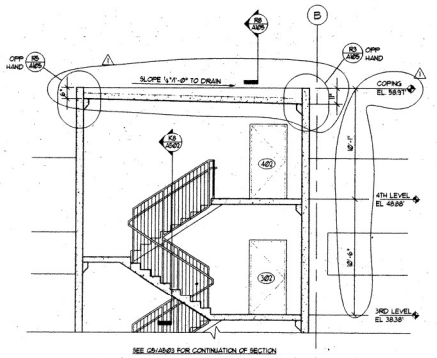

E5	STAIR #2 SECTION ALTERNATE #1
SCALE: ¼"=1'-0"	A601

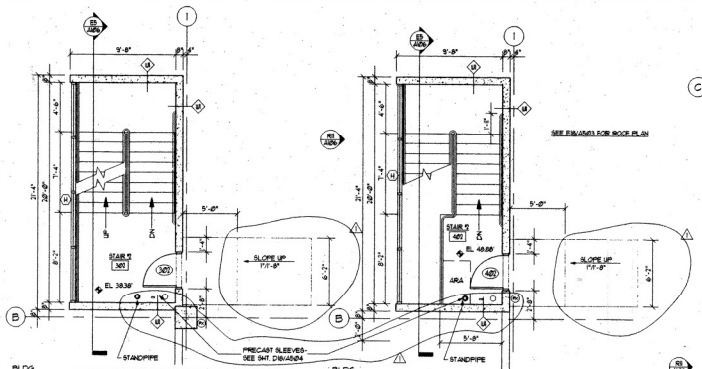

E9	STAIR #2 3RD LEVEL ALTERNATE #1
SCALE: ¼"=1'-0"	A601

E12	STAIR #2 4TH LEVEL ALTERNATE #1
SCALE: ¼"=1'-0"	A601

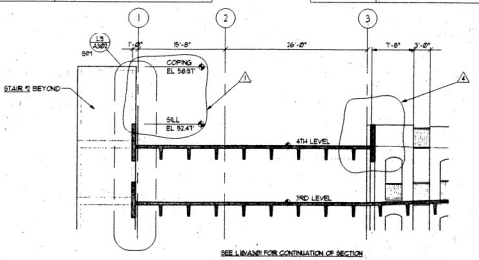

J8	PART BLDG SECTION ALTERNATE #1
SCALE: ¼"=1'-0"	A601

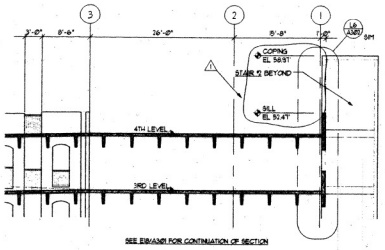

J13	PART BLDG SECTION ALTERNATE #1
SCALE: ¼"=1'-0"	A601

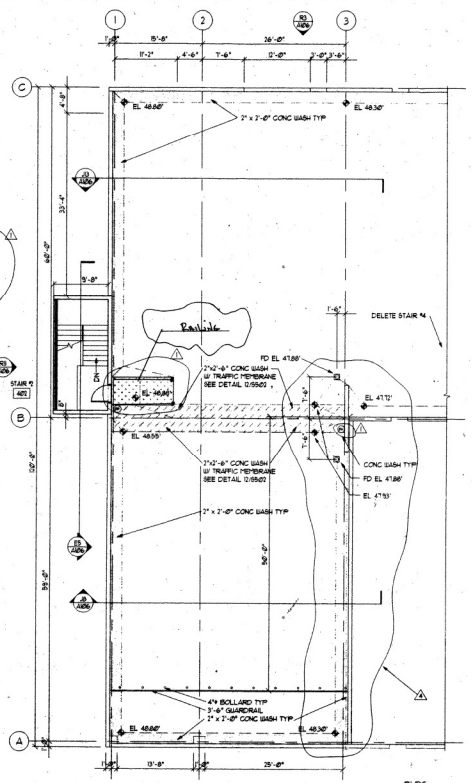

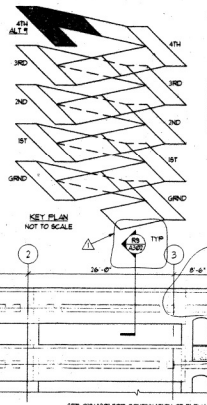

M18	4TH LEV PART PLAN ALTERNATE #1
SCALE: ⅛"=1'-0"	A601

NOTE: STAIR #4 SHALL BE DELETED IN ALTERNATE #1

GENERAL NOTES:

1. SEE SHEET G0103 FOR STRIPING PLANS
2. SEE SHEET A6401 FOR SIGNAGE PLANS
3. REF. EL. 0'-0" = 331.40'
4. RE: CURBS- ALL VERT. SURFACES WITHIN 6" OF EDGES TO BE PT. SAFETY YELLOW.

FLOOR SURFACE KEY:

- CONCRETE WASH
- TRAFFIC MEMBRANE SEE P9A/A302
- SLIP RESISTANT COATING

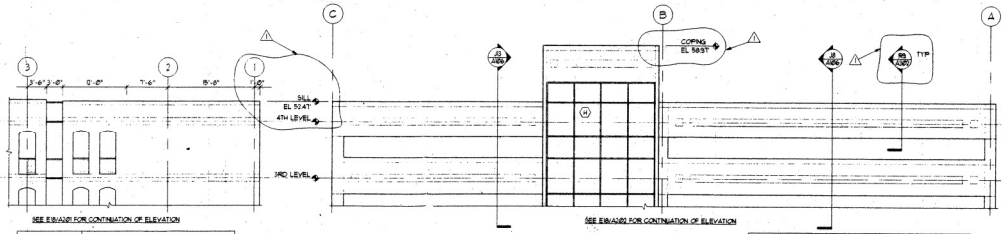

R3	NORTH PART ELEV ALTERNATE #1
SCALE: ⅛"=1'-0"	A601

R11	WEST PART ELEV ALTERNATE #1
SCALE: ⅛"=1'-0"	A601

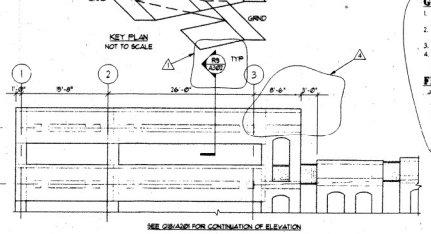

R17	SOUTH PART ELEV ALTERNATE #1
SCALE: ⅛"=1'-0"	A601

REVISIONS
1 REVISION NO. 1 8-31-94
2 REVISION NO. 4 - CLARIFICATION & CORRECTIONS 01-02-95

PROJECT NAME
PARKING GARAGE No. 9
MONTGOMERY, COUNTY

SHEET TITLE
ALTERNATE #1 - 4th DECK PLANS, SECTIONS & ELEVATIONS

JOB NUMBER
106-94

DATE
12-01-94

SHEET NUMBER
A106

ARCHITECTS • PLANNERS
DEVELOPMENT CONSULTANTS
DRBrasher
10227 WINCOPIN CIRCLE, SUITE 700 COLUMBIA, MD 21044
BALTO. (410)995-0015 • WASH./VA. (301)621-6020

26-94A06 03-01-95 NONE 1-96

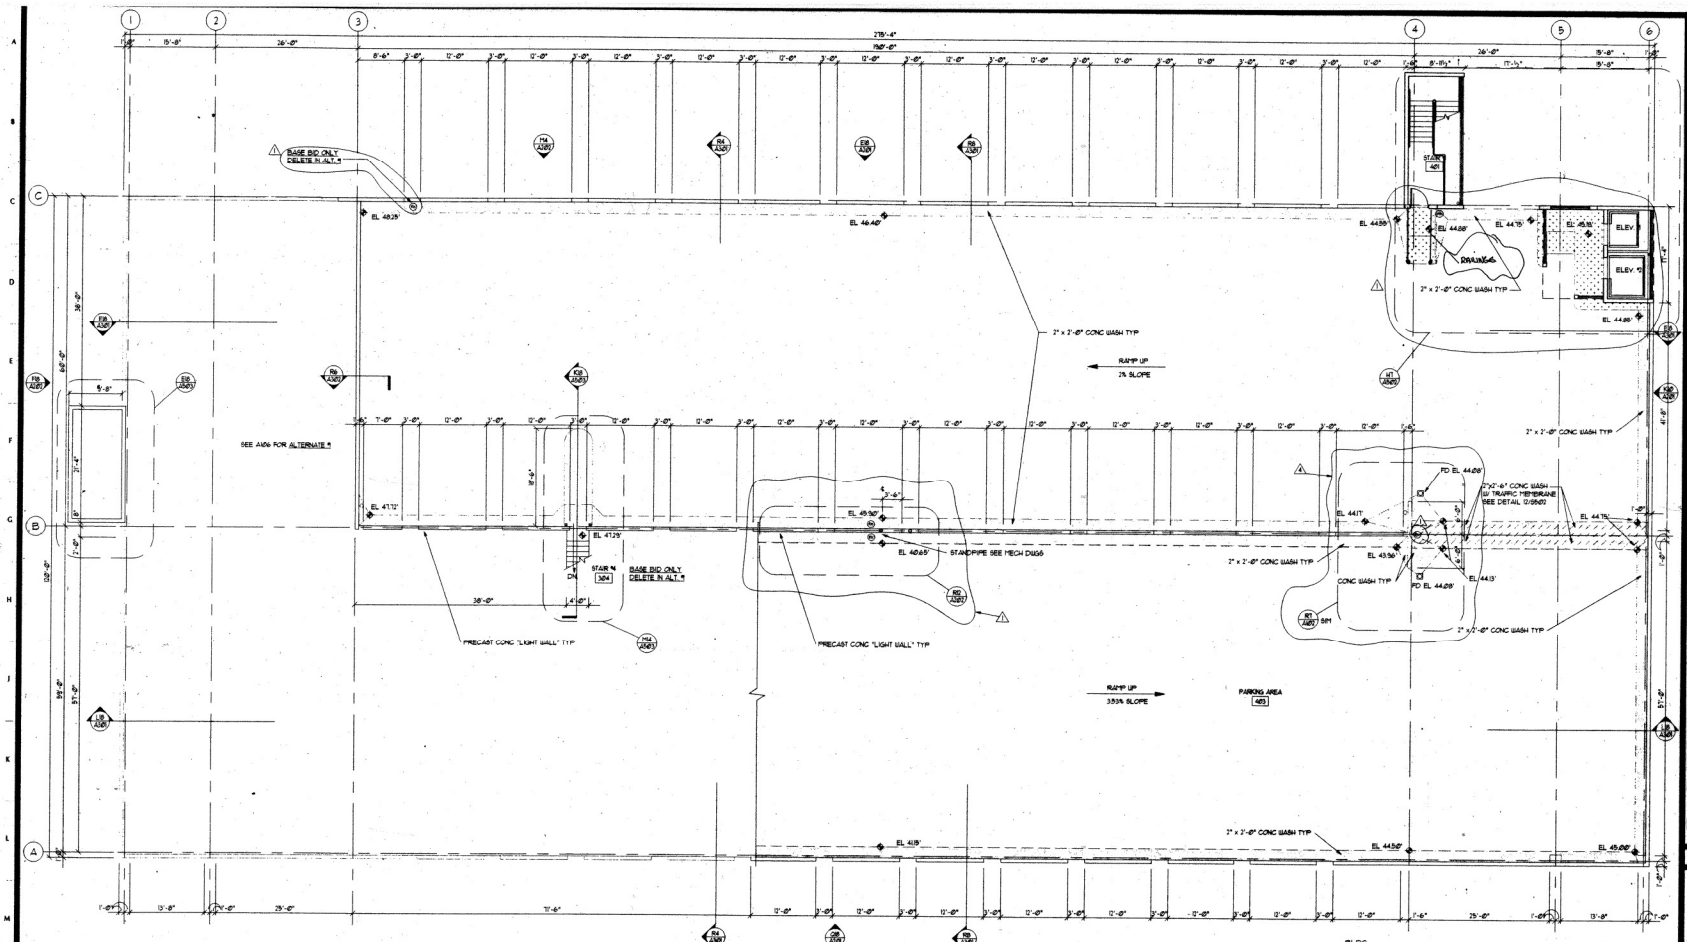

K18	4TH LEVEL PLAN
SCALE: 1/8"=1'-0"	

GENERAL NOTES:

1. SEE SHEET G0003 FOR STRIPING PLANS
2. SEE SHEET A801 FOR SIGNAGE PLANS
3. REF. EL. 0.00' = 331.40'
4. RE. CURBS - ALL VERT. SURFACES & LATAIN 6" OR EDGES TO BE PT SAFETY YELLOW

FLOOR SURFACE KEY:

- CONCRETE WASH
- TRAFFIC MEMBRANE SEE P18/A3612
- SLIP RESISTANT COATING

R3	TYP PARAPET DTL	R5	TYP PARAPET DTL	R8	TYP PARAPET DTL	R11	TYP SCUPPER	R14	TYP OVERFLOW
SCALE: 1½"=1'-0"	A106, A501, A502, A503	SCALE: 1½"=1'-0"	A106, A501, A502, A503	SCALE: 1½"=1'-0"	A106, A501, A502, A503	SCALE: 1½"=1'-0"	A105, A502, A503	SCALE: 1½"=1'-0"	A105, A502, A501, A502, A503

REVISIONS

1 REVISION NO. 1 - CLARIFICATION / CODES 10-27-94
2 REVISION NO. 2 - CLARIFICATION / CODES 12-01-94

PROJECT NAME
PARKING GARAGE No. 9
MONTGOMERY, COUNTY

SHEET TITLE
4TH LEVEL PLAN & ROOF DETAILS

JOB NUMBER
106-94

DATE
12-01-94

SHEET NUMBER
A105

ARCHITECTS • PLANNERS
DEVELOPMENT CONSULTANTS

DRBrasher

10227 WINCOPIN CIRCLE, SUITE 700 COLUMBIA, MD 21044
BALTO. (410)995-0015 • WASH./VA. (301)621-6020

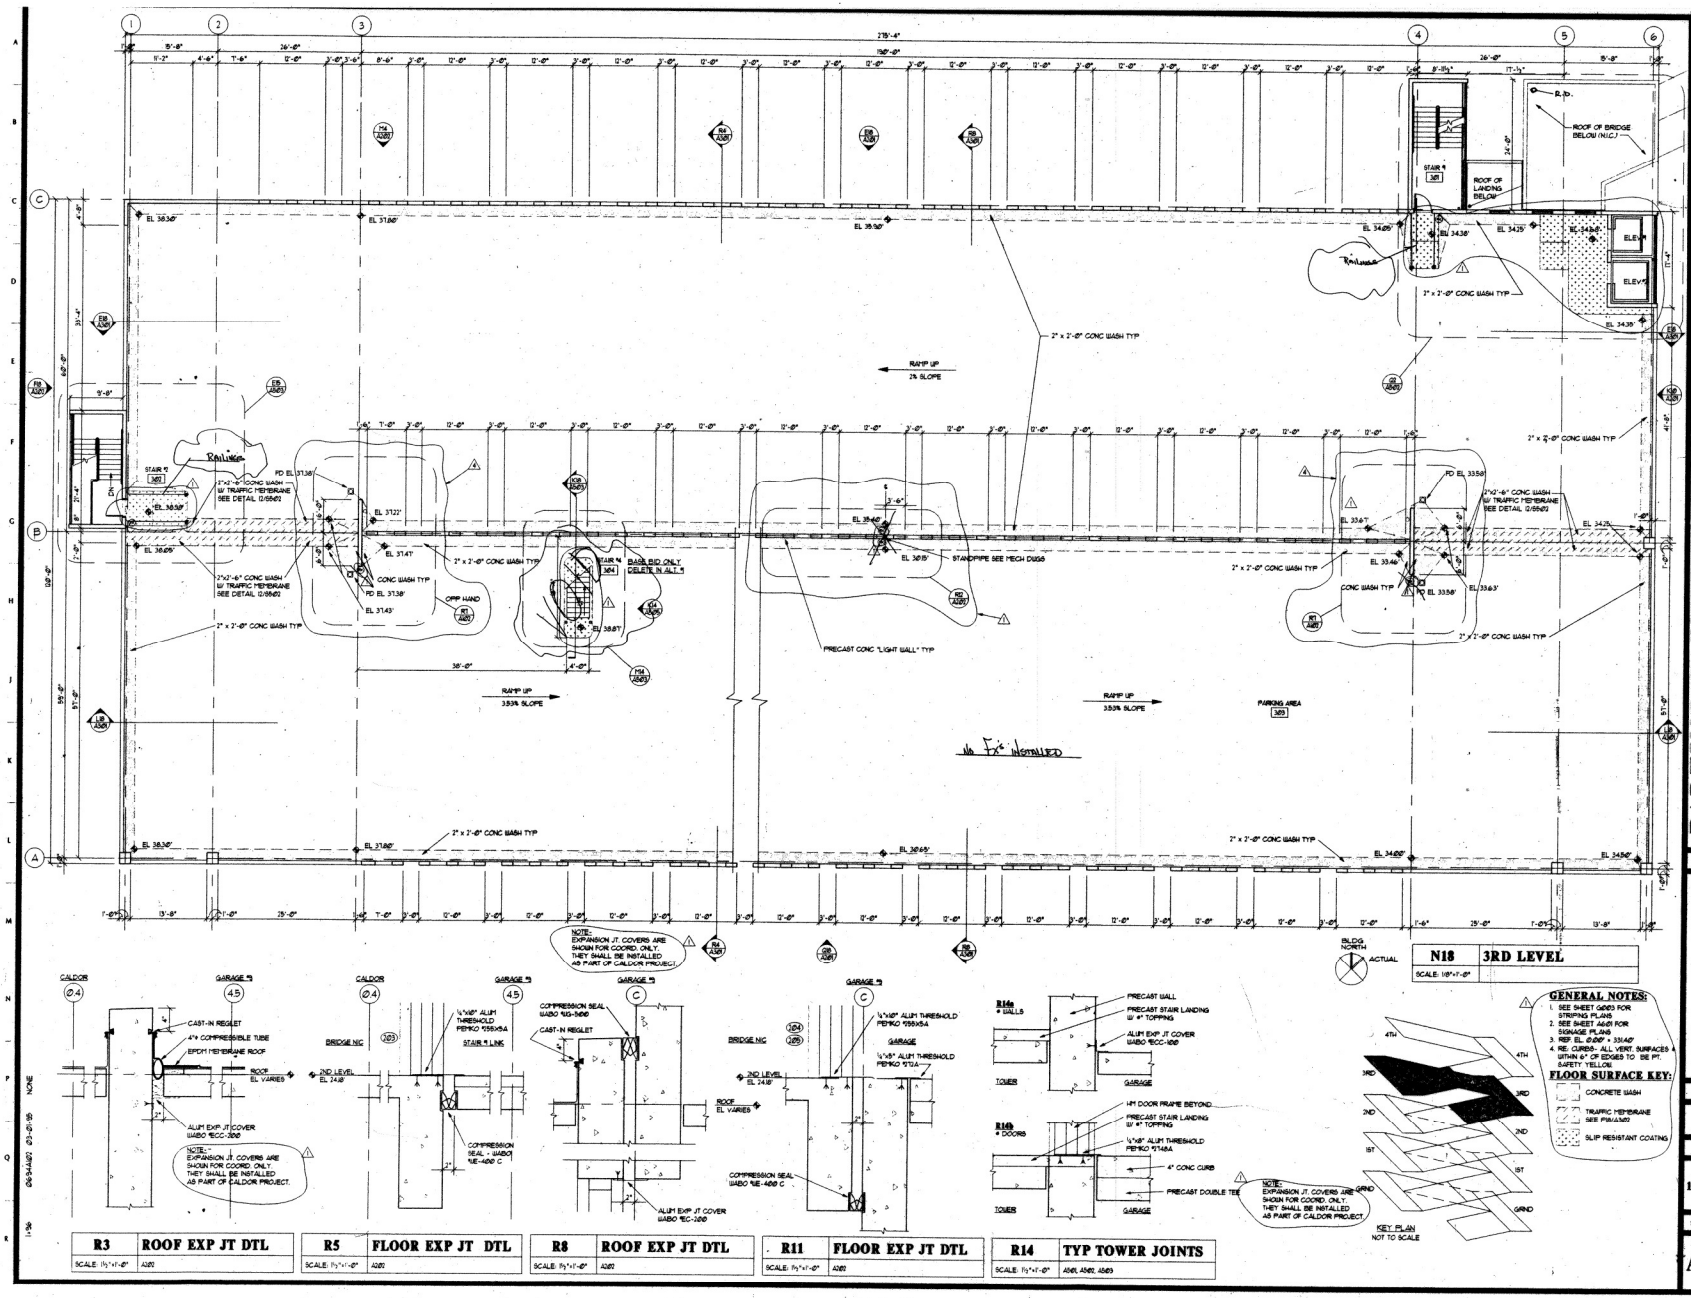

N18	3RD LEVEL
SCALE: 1/8"=1'-0"	

GENERAL NOTES:

3. REF EL. 0'-0" = 331.40'
4. RE. CURBS- ALL VERT. SURFACES WITHIN 6" OF EDGES TO BE PT. SAFETY YELLOW

FLOOR SURFACE KEY:

- CONCRETE WASH
- TRAFFIC MEMBRANE SEE PW.A0.02
- SLIP RESISTANT COATING

R3	ROOF EXP JT DTL
SCALE: 1½"=1'-0"	A2.01

R5	FLOOR EXP JT DTL
SCALE: 1½"=1'-0"	A2.01

R8	ROOF EXP JT DTL
SCALE: 1½"=1'-0"	A2.01

R11	FLOOR EXP JT DTL
SCALE: 1½"=1'-0"	A2.01

R14	TYP TOWER JOINTS
SCALE: 1½"=1'-0"	A5.01, A5.02, A5.03

ARCHITECTS • PLANNERS
DEVELOPMENT CONSULTANTS

DRBrasher

10227 WINCOPIN CIRCLE, SUITE 700 COLUMBIA, MD 21044
BALTO. (410)995-0015 • WASH./VA. (301)621-6020

REVISIONS:
1 REVISION NO. 1 - CLARIFICATION + CODRD 10-07-94

PROJECT NAME
PARKING GARAGE No. 9
MONTGOMERY, COUNTY

SHEET TITLE
3RD LEVEL PLAN
EXPANSION JOINT DETAILS

JOB NUMBER
106-94

DATE
12-01-94

SHEET NUMBER
A104

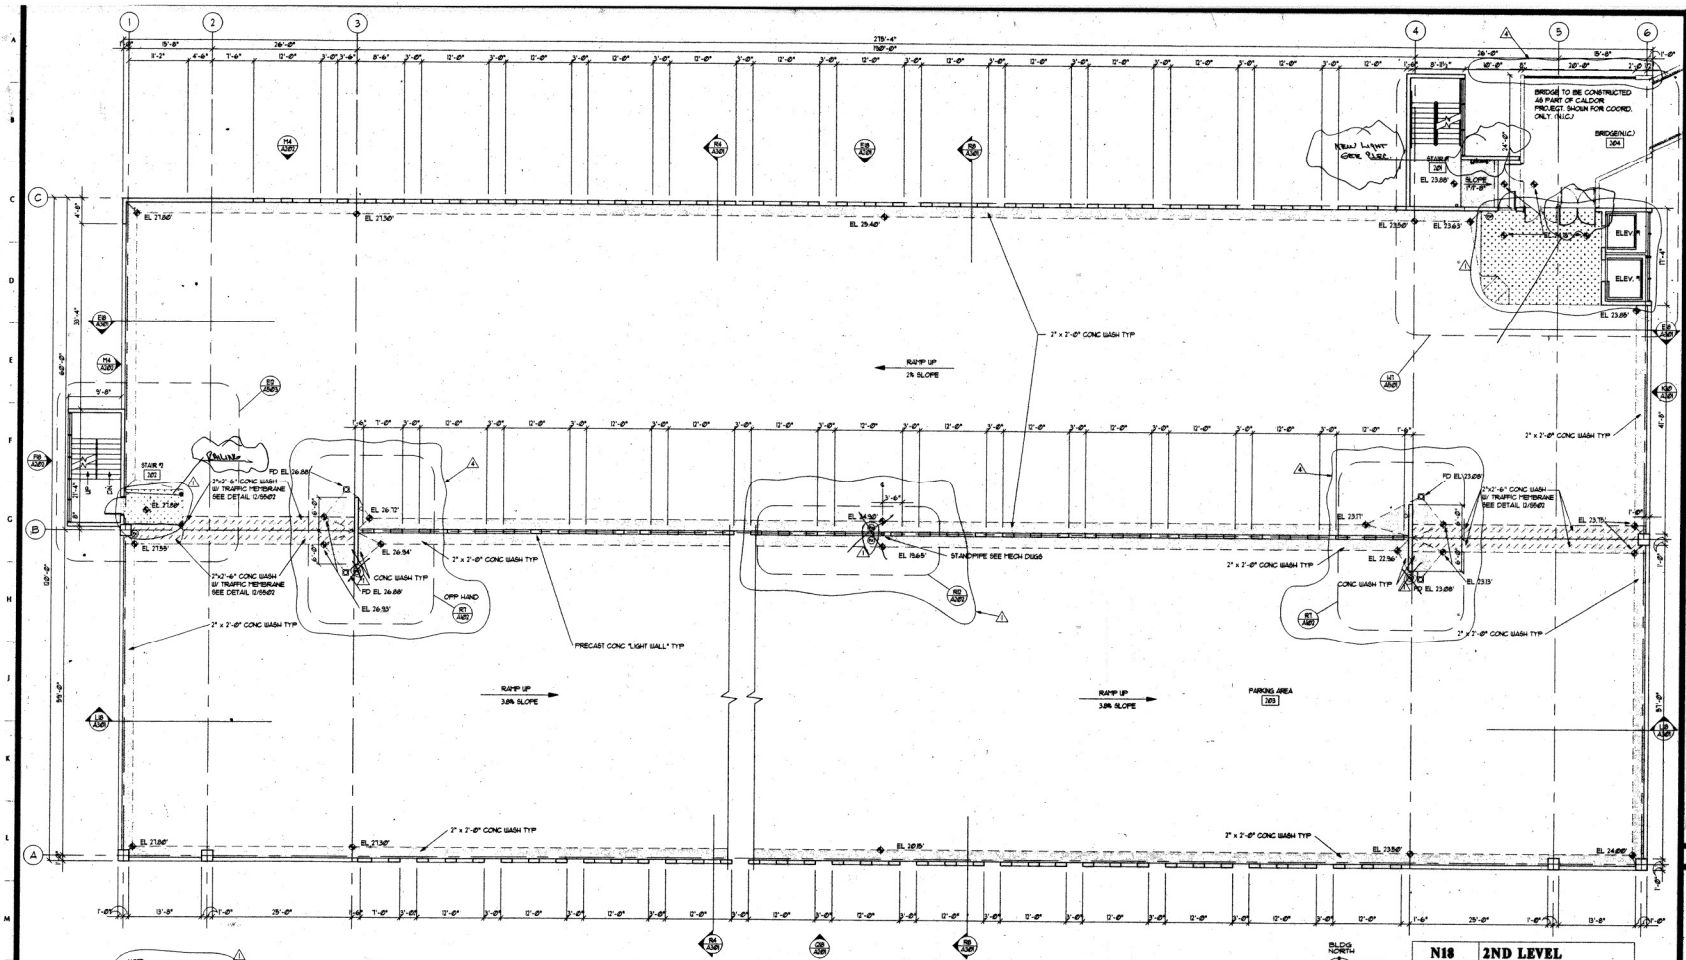

NOTE: EXPANSION JT. COVERS SHOWN FOR COORDINATION ONLY. THEY SHALL BE INSTALLED AS PART OF CALDOR PROJECT.

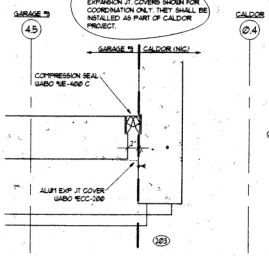

R3	WALL EXP JT DTL
SCALE: 1½"=1'-0"	A501

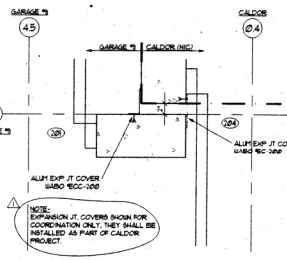

NOTE: EXPANSION JT. COVERS SHOWN FOR COORDINATION ONLY. THEY SHALL BE INSTALLED AS PART OF CALDOR PROJECT.

R7	WALL EXP JT DTL
SCALE: 1½"=1'-0"	A501

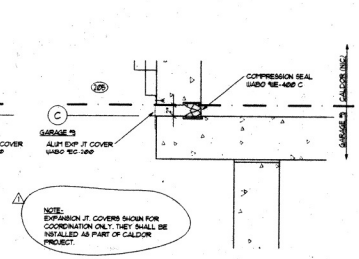

NOTE: EXPANSION JT. COVERS SHOWN FOR COORDINATION ONLY. THEY SHALL BE INSTALLED AS PART OF CALDOR PROJECT.

R10	WALL EXP JT DTL
SCALE: 1½"=1'-0"	A501

N18	2ND LEVEL
SCALE: 1/8"=1'-0"	

GENERAL NOTES:

1. SEE SHEET G060 FOR STRIPING PLANS
2. SEE SHEET A601 FOR SIGNAGE PLANS
3. REF EL. 21.00' = 331.48'
4. RE: CURBS- ALL VERT. SURFACES 4 WITHIN 6" OF EDGES TO BE PT. SAFETY YELLOW.

FLOOR SURFACE KEY:

- CONCRETE WASH
- TRAFFIC MEMBRANE SEE P18/A3/02
- SLIP RESISTANT COATING

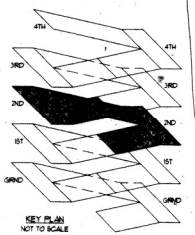

KEY PLAN
NOT TO SCALE

REVISIONS	
REVISION NO. 1	2-28-94
REVISION NO. 2 - CLARIFICATION + COORD	10-20-94

ARCHITECTS • PLANNERS
DEVELOPMENT CONSULTANTS
DRBrasher
10227 WINCOPIN CIRCLE, SUITE 700 COLUMBIA, MD 21044
BALTO. (410)995-6015 • WASH./VA. (301)621-6020

PROJECT NAME: PARKING GARAGE No. 9
MONTGOMERY, COUNTY

SHEET TITLE: 2ND LEVEL PLAN
EXPANSION JOINT DETAILS

JOB NUMBER: 106-94

DATE: 12-01-94

SHEET NUMBER: A103

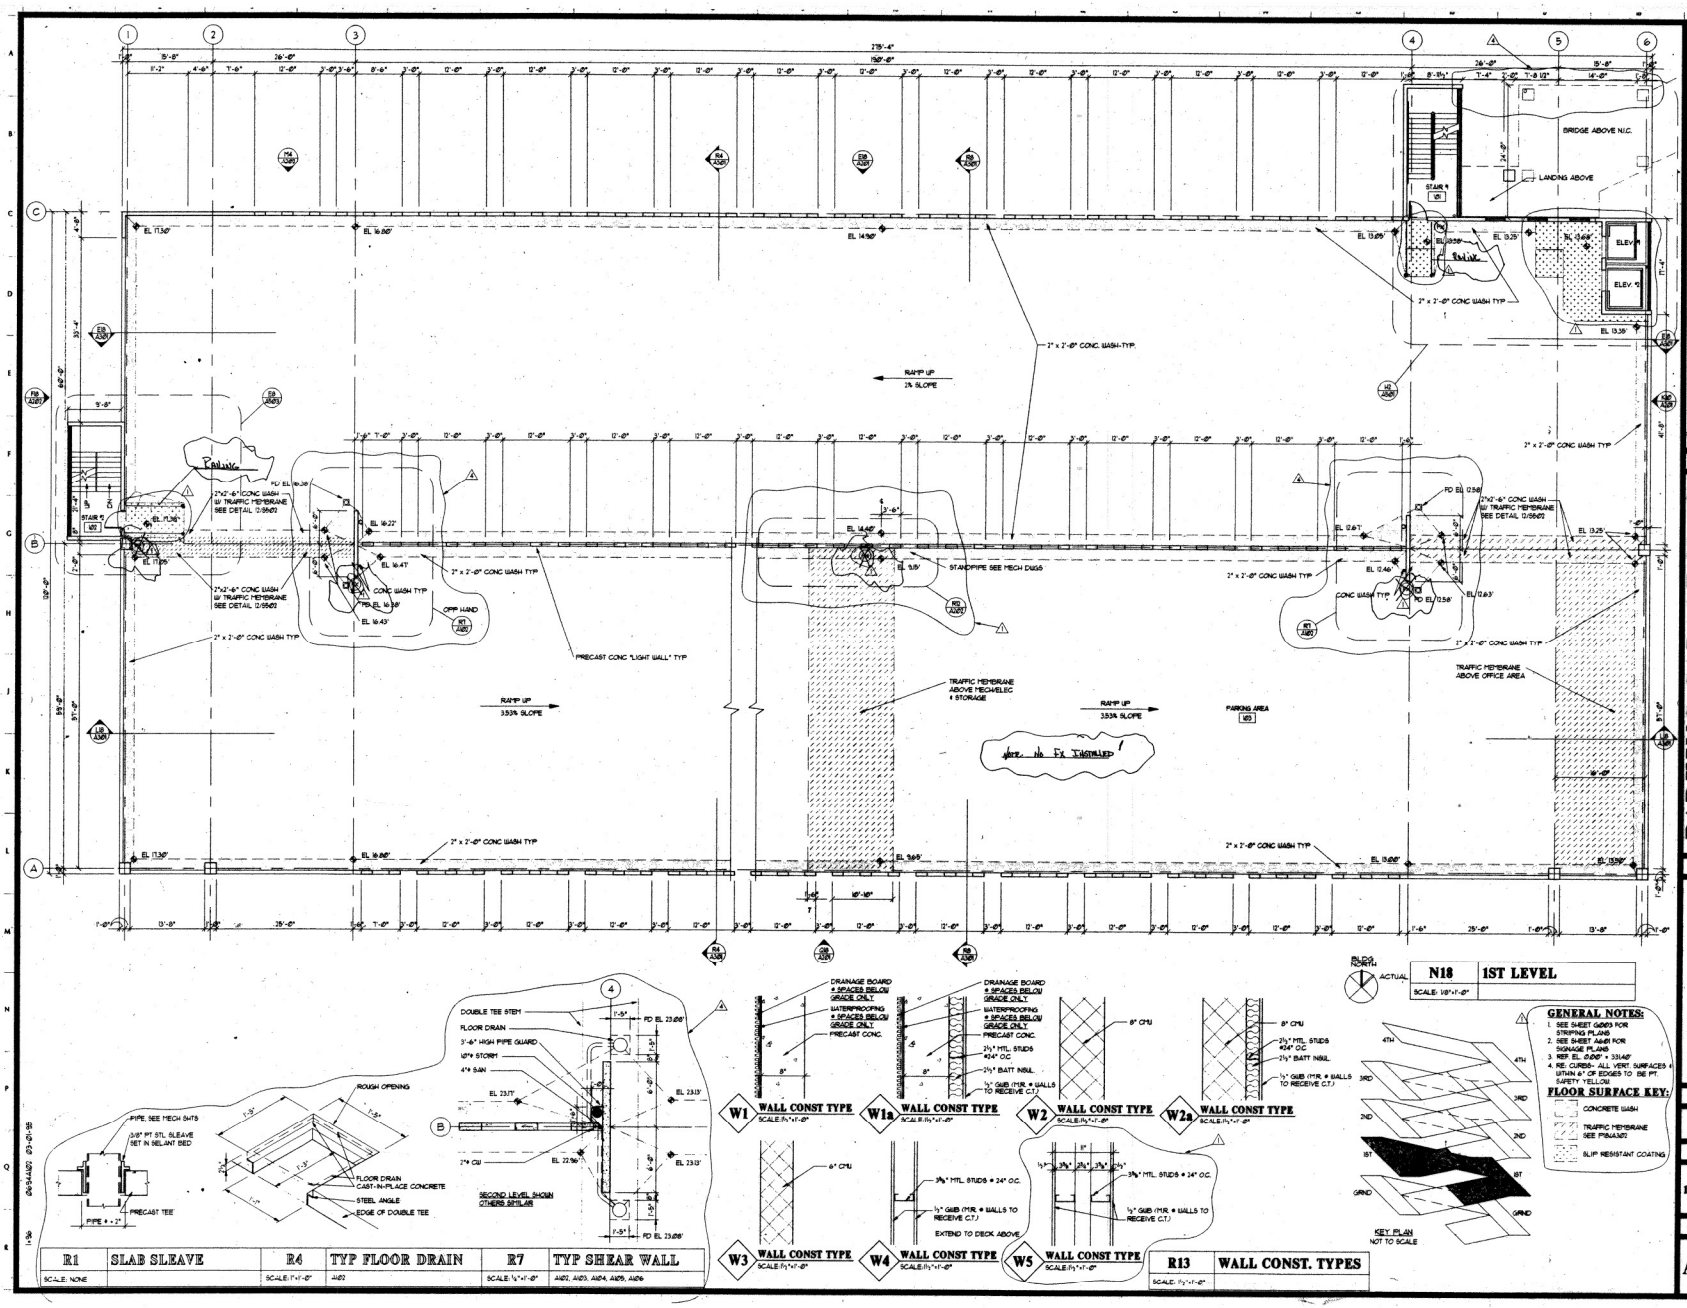

REVISIONS

1 REVISION NO. 1 12-31-94
2 REVISION NO. 2 - CLARIFICATION & CODES 05-20-95

PROJECT NAME
PARKING GARAGE No. 9
MONTGOMERY, COUNTY

SHEET TITLE
1ST LEVEL PLAN
WALL CONSTRUCTION TYPES

JOB NUMBER 106-94

DATE 12-01-94

SHEET NUMBER A102

DRBrasher
ARCHITECTS • PLANNERS
DEVELOPMENT CONSULTANTS
10227 WINCOPIN CIRCLE, SUITE 700 COLUMBIA, MD 21044
BALTO. (410)995-0015 • WASH./VA. (301)621-6020

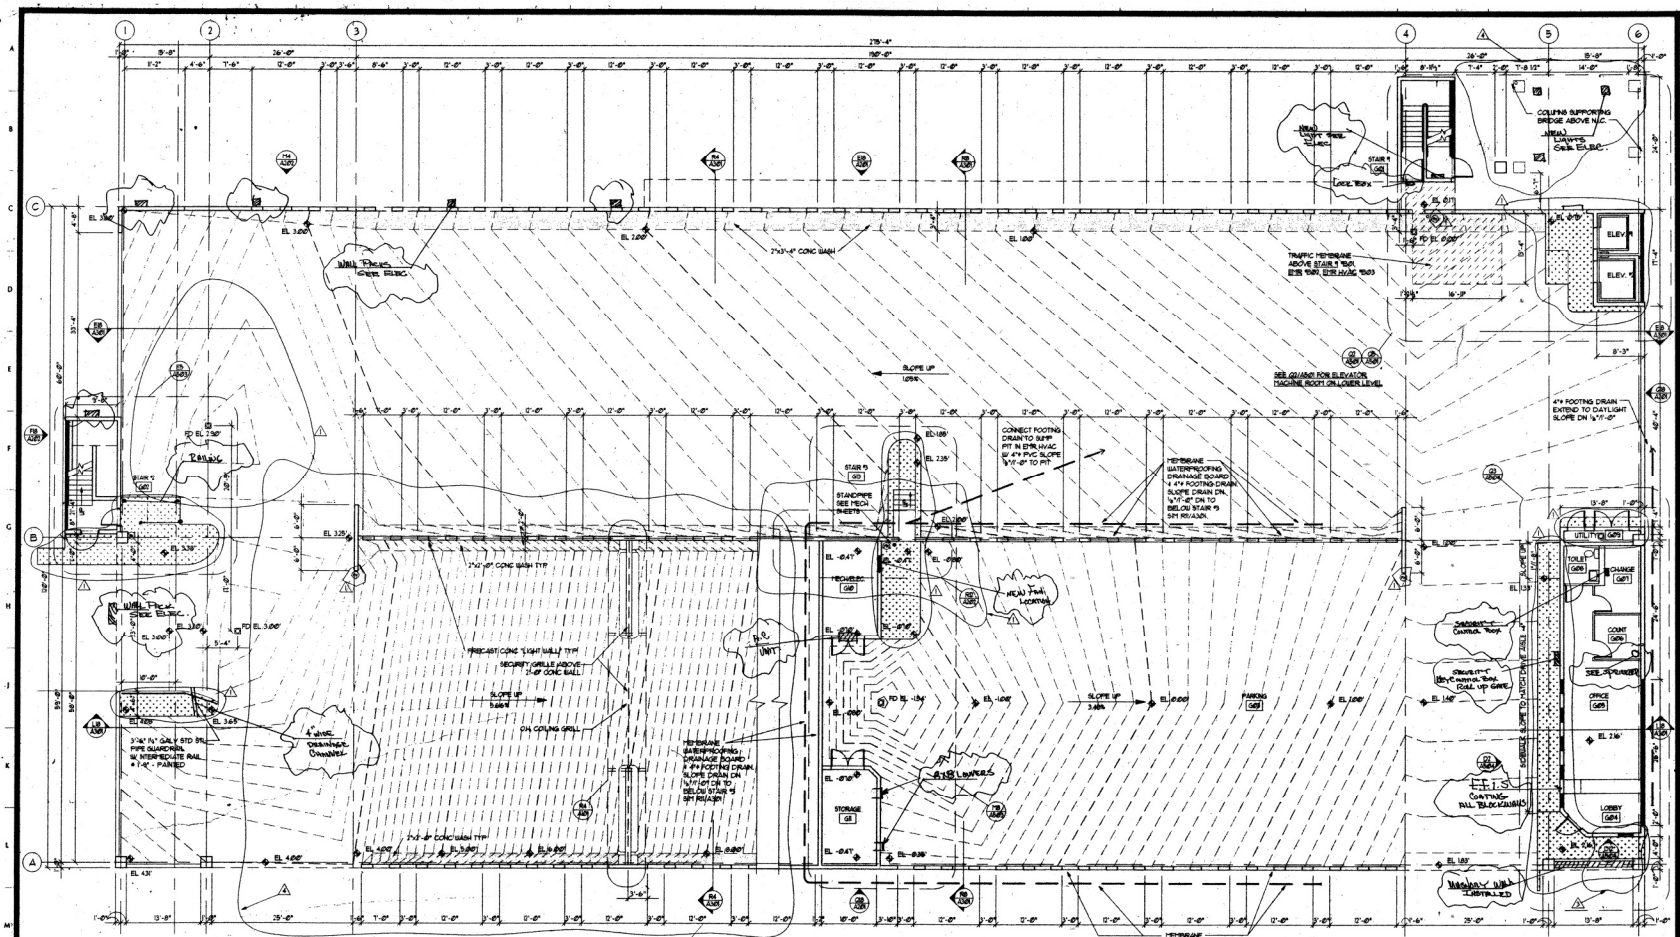

R4	OH GRILLE PLAN
SCALE: 1/4"=1'-0"	AIA

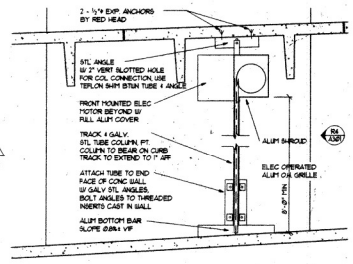

R7	OH GRILLE SECTION
SCALE: 1½"=1'-0"	AIA

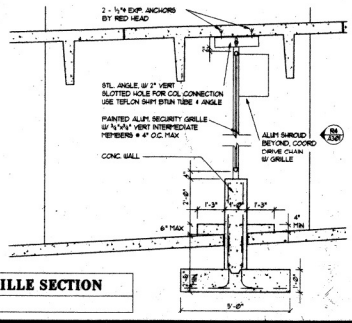

R10	GRILLE SECTION
SCALE: 1½"=1'-0"	AIA

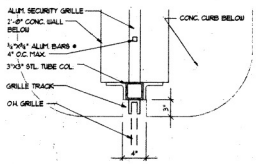

R13	OH GRILLE JAMB
SCALE: 1½"=1'-0"	AIA

BLDG. NORTH ACTUAL

M18	GROUND LEVEL
SCALE: 1/8"=1'-0"	

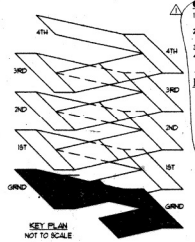

GENERAL NOTES:

1. SEE SHEET G005 FOR STRIPING PLANS
2. SEE SHEET A626 FOR SIGNAGE PLANS
3. REF. EL. 0.00 = 133.40'
4. RE. CURBS- ALL VERT. SURFACES 4 WITHIN 6" OF EDGES TO BE PT. SAFETY YELLOW

FLOOR SURFACE KEY:

- CONCRETE WASH
- TRAFFIC MEMBRANE SEE P18/A3.02
- SLIP RESISTANT COATING

REVISIONS
REVISION NO. 1 - MEDOP COMMENTS 12-30-94
REVISION NO. 2 - CLARIFICATION / CODING 03-07-95
REVISION NO. 3 - 03-07-95

PROJECT NAME: PARKING GARAGE No. 9
MONTGOMERY, COUNTY

SHEET TITLE: GROUND LEVEL PLAN & DETAILS

JOB NUMBER: 106-94

DATE: 12-01-94

SHEET NUMBER: A101

ARCHITECTS • PLANNERS
DEVELOPMENT CONSULTANTS

DRBrasher

10227 WINCOPIN CIRCLE, SUITE 700 COLUMBIA, MD 21044
BALTO. (410)995-0415 • WASH./VA. (301)621-6020

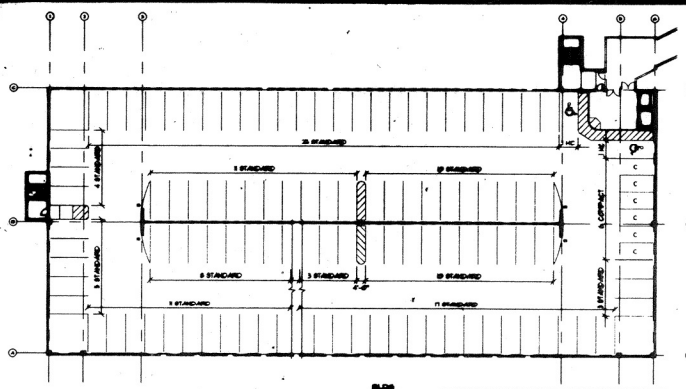

B8	2ND LEVEL
SCALE: 1/32"=1'-0"	A08

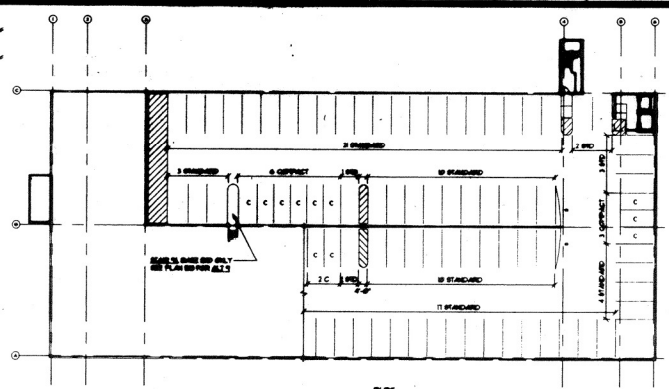

K15	4TH LEVEL
SCALE: 1/32"=1'-0"	A08

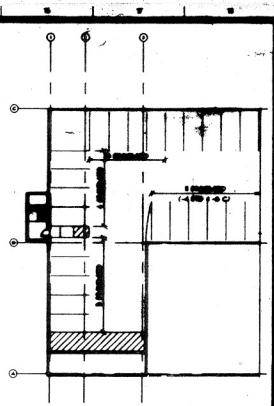

K16	4TH LEVEL ALT #1
SCALE: 1/32"=1'-0"	A08

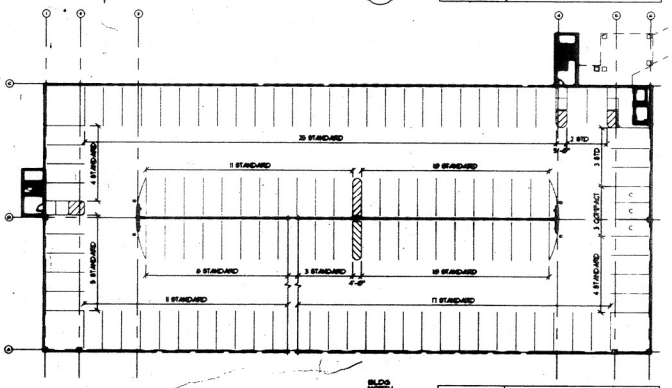

K8	1ST LEVEL
SCALE: 1/32"=1'-0"	A08

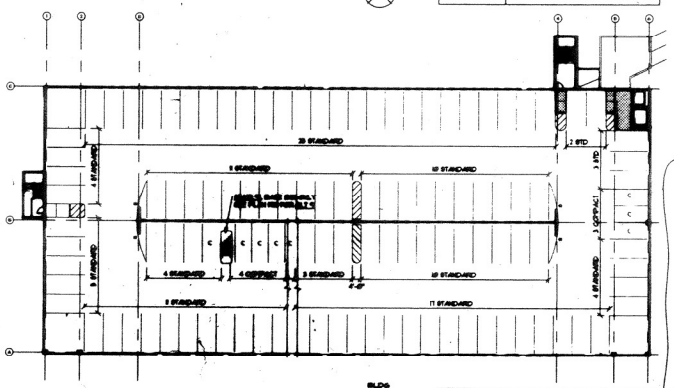

K15	3RD LEVEL
SCALE: 1/32"=1'-0"	A04

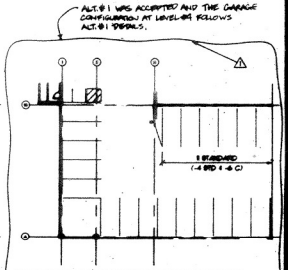

K16	3RD LEVEL ALT #1
SCALE: 1/32"=1'-0"	A04

	STANDARD	COMPACT	H/C	TOTAL
4TH LEVEL	72	7	--	81
3RD LEVEL	69	7	--	76
2ND LEVEL	69	6	3	78
1ST LEVEL	58	5	3	66
GROUND LEVEL	45	5	3 (1 VAN)	53
PENTHOUSE	48	4	2	54
BASE AND SCHOOL	68	14	4	86
ALT. 1 CHANGES	+6	+2	+1	+9
ALT. 1 TOTALS	74	16	5	95

N12	PARKING COUNTS
SCALE: NONE	

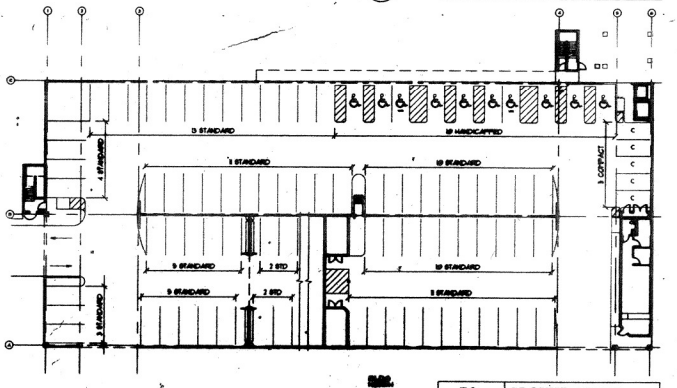

R8	GROUND LEVEL
SCALE: 1/32"=1'-0"	A08

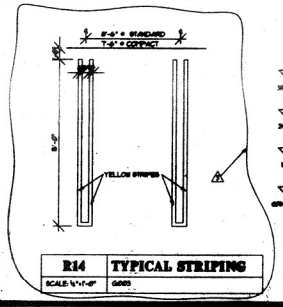

R14	TYPICAL STRIPING
SCALE: 1/4"=1'-0"	G005

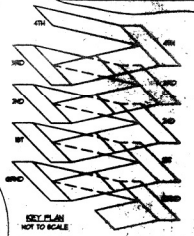

KEY PLAN
NOT TO SCALE

PARKING GARAGE No. 9
MONTGOMERY, COUNTY

PARKING PLANS

DRRacher
ARCHITECTS • PLANNERS
CONSULTANTS

8227 WOODMONT AVENUE, SUITE 200, BETHESDA, MD 20814
PHONE: (301) 654-8660 • WASHINGTON, D.C.

G005

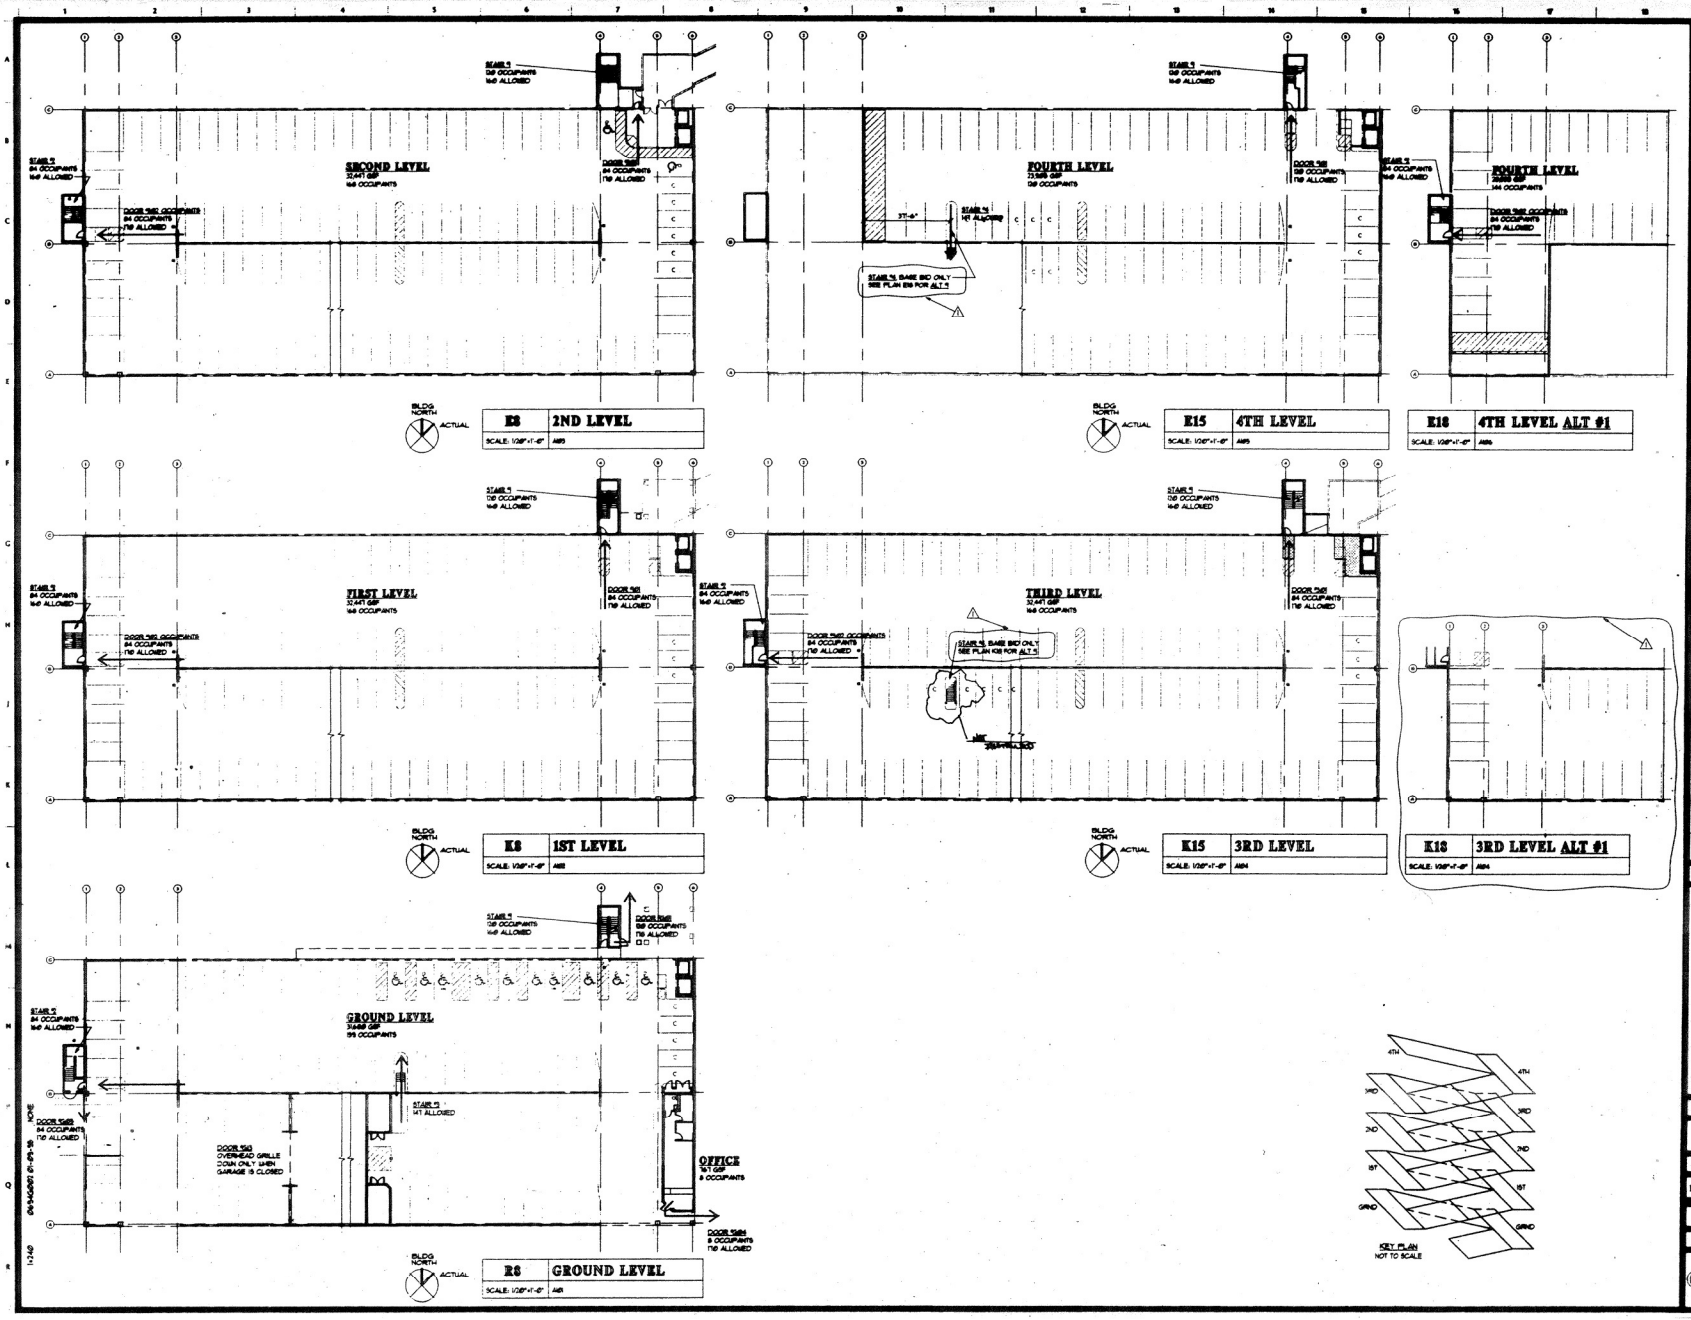

PARKING GARAGE No. 9
MONTGOMERY, COUNTY

EGRESS PLANS

G002

DRBrasher
ARCHITECTS • PLANNERS
DEVELOPMENT CONSULTANTS

10227 WINCOPIN CIRCLE, SUITE 700 COLUMBIA, MD 21044
BALTO. (410)995-0015 • WASH./VA. (301)621-6020

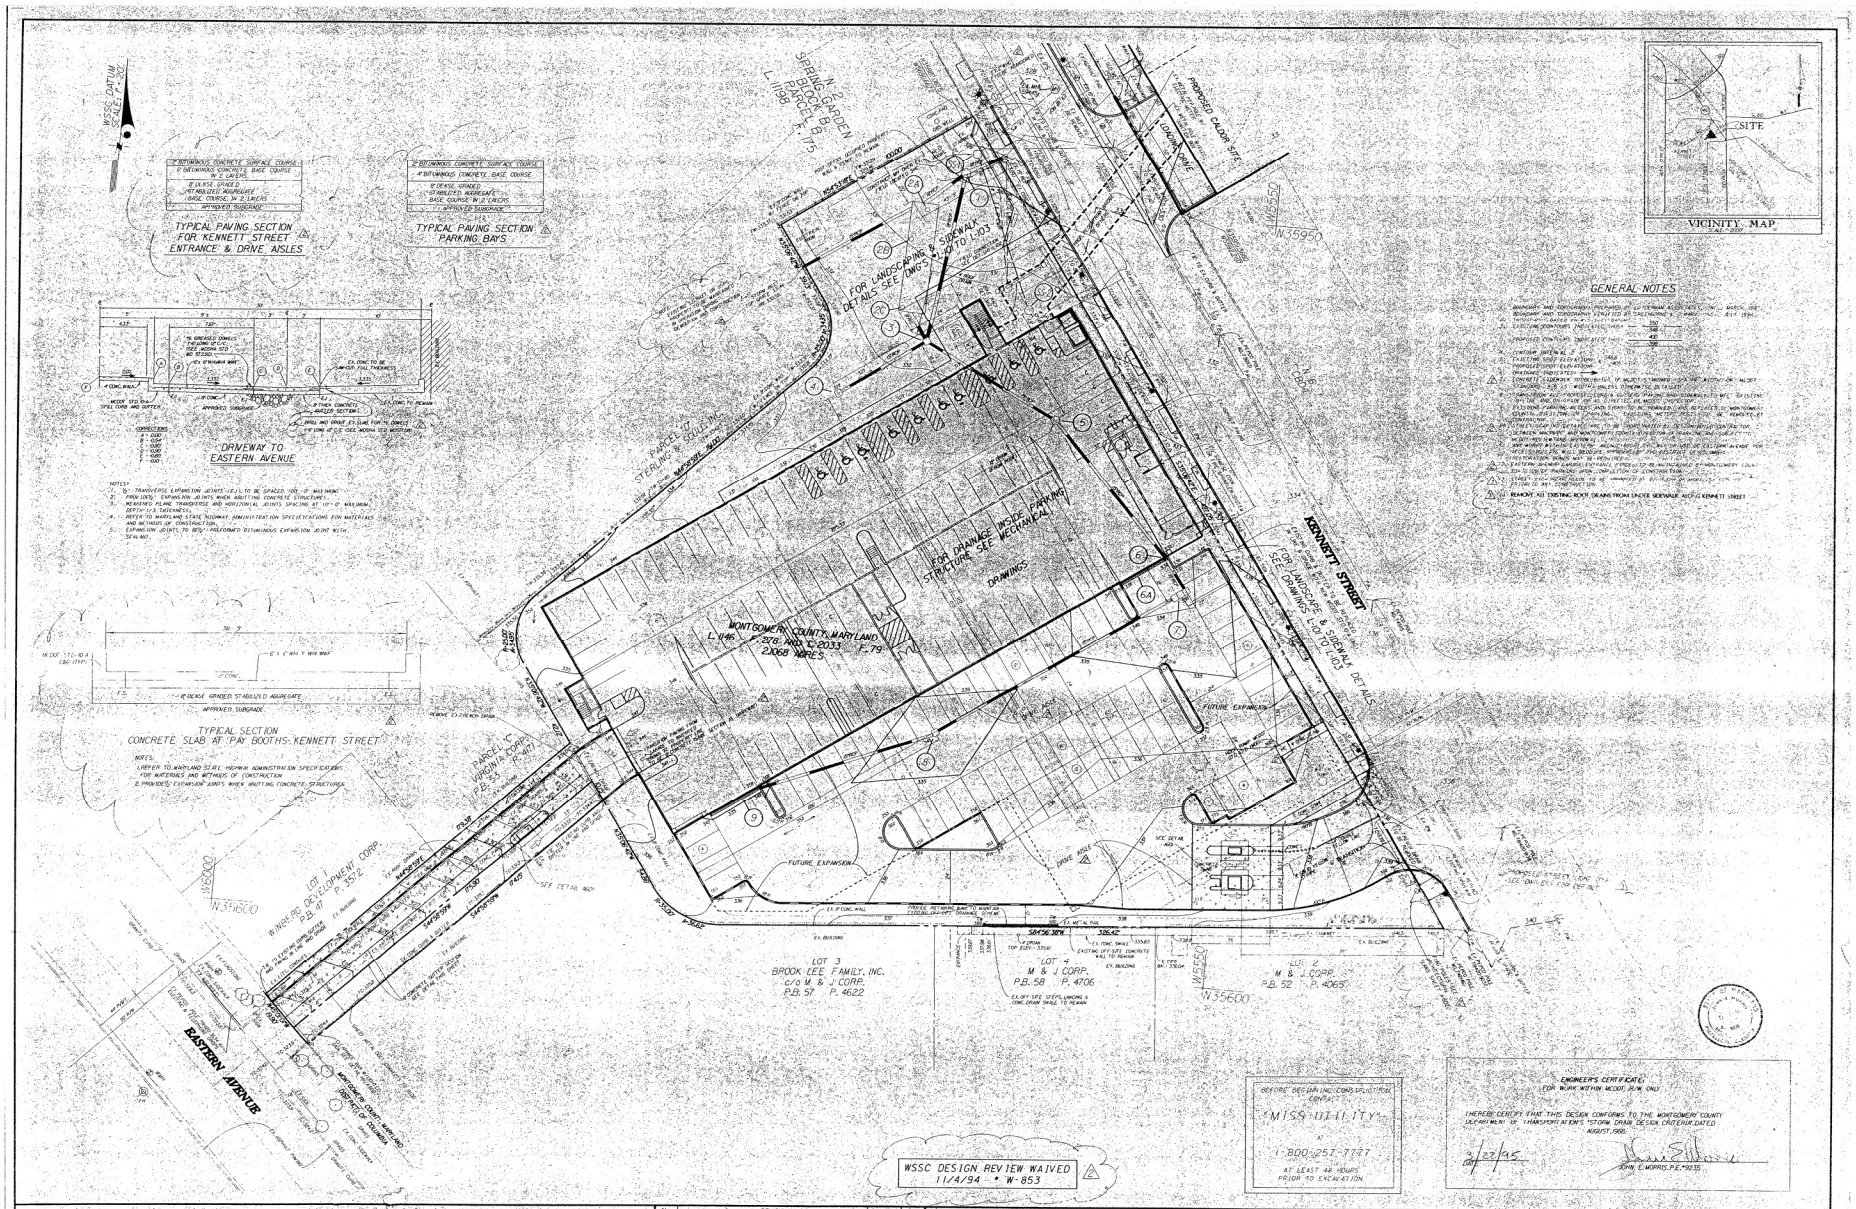
WSSC DATUM
SILVER SPRING
N 35°50'
N 35°55'
N 35600
N 35950
N 36000
TYPICAL PAVING SECTION
FOR KENNETT STREET
ENTRANCE & DRIVE AISLES
TYPICAL PAVING SECTION
PARKING BAYS
DRIVEWAY TO
EASTERN AVENUE
TYPICAL SECTION
CONCRETE SLAB AT PAY BOOTHS-KENNETT STREET
NOTES:
1. ½" TRANSVERSE EXPANSION JOINTS (E.J.) TO BE SPACED 100'-0" MAXIMUM.
2. PROVIDE ½" EXPANSION JOINTS WHEN ABUTTING CONCRETE STRUCTURES.
3. MEASURED ALONG TRANSVERSE AND HORIZONTAL JOINTS SPACING AT 10'-0" MAXIMUM.
DEPTH=1/3 THICKNESS.
4. REFER TO MARYLAND STATE HIGHWAY ADMINISTRATION SPECIFICATIONS FOR MATERIALS AND METHODS OF CONSTRUCTION.
5. EXPANSION JOINTS TO BE PREFORMED BITUMINOUS EXPANSION JOINT WITH SEALANT.
KENNETT STREET
EASTERN AVENUE
PARCEL 47
STERLING BUILDING
PARCEL 48
VIRGINIA CORP.
P.B. 53
LOT 1
WHITE PIC DEVELOPMENT CORP.
P.B. 47 P. 312
LOT 3
BROOK LEE FAMILY, INC.
c/o M. & J CORP.
P.B. 57 P. 4622
LOT 4
M & J CORP.
P.B. 58 P. 4706
LOT 2
M & J CORP.
P.B. 52 P. 4065
MONTGOMERY COUNTY, MARYLAND
L. 1146 F. 278; NO. 12-2033 F. 79
2.068 ACRES
N.Z. GARDEN
SPRING GARDEN
PARCEL B
L. 1198 F. 175
PROPOSED CANOPY SITE
FOR LANDSCAPING & SIDEWALK
DETAILS SEE DWG. 1 OF 1 TO 1 OF 3
FOR PLANTING INSIDE PARKING
STRUCTURE SEE MECHANICAL
DRAWINGS
FOR LANDSCAPE & SIDEWALK DETAILS
SEE DRAWINGS 1 OF 3 TO 3 OF 3
FUTURE EXPANSION
DRIVE AISLE
SEE DETAIL #6
SEE DETAIL #4
SEE DETAIL #5
PROVIDE RETAINING WALL
TO MAINTAIN EX. GRADE
EX. BUILDING
EX. CONC. WALL
EX. METAL PIER
EX. CONC. SHED
EXISTING OFF-SITE CONCRETE WALL TO REMAIN
EX. OFF-SITE STEPS, LANDING & CONC. DRIVE SHED TO REMAIN
EX. DRIVE TOP ELEV.=335.61
EX. DRIVE TOP ELEV.=337.61
EX. DRIVE TOP

DRBrasher

Architects · Planners · Development Consultants
Columbia, Maryland

PARKING GARAGE No. 9

8040 KENNETT STREET
SILVER SPRING, MARYLAND

DEVELOPER:
CALDOR CORPORATION
C/O: TROUT, SEGALL & DOYLE, INC.
SUITE 229, VILLAGE SQUARE, VILLAGE OF CROSS KEYS, BALTIMORE, MD, 21210
(410) 435-4000 FAX: (410) 435-4277

CONTRACTOR:
JEFFERY M. BROWN
3337 PHILMONT AVE., HUNTINGTON VALLEY, PA 19006
(410) 664-9100 FAX: (410) 664-9147

STRUCTURAL ENGINEER:
MEYER CONSULTING ENGINEERS
451 HUNGERFORD DR. SUITE 113, ROCKVILLE, MD 20850
(301) 738-5690 FAX: (301) 738-5695

PRECAST CONTRACTOR:
TINDALL CONCRETE VIRGINIA, INC.
5400 OLGERS RD., PETERSBURG, VA 23803
(804) 861-0447 FAX: (804) 862-6353

CIVIL ENGINEER:
GREENHORNE AND O'MARA, INC.
15020 SHADY GROVE RD. SUITE 300, ROCKVILLE, MD. 20850
(301) 738-3090 FAX (301) 424-1282

MECHANICAL/ELECTRICAL/PLUMBING ENGINEER:
SHEFFERMAN & BIGELSON CO.
8455 COLESVILLE RD., SILVER SPRING, MD. 20910
(301) 587-4433 FAX (301) 495-5762

PARKING CONSULTANT:
CARL WALKER, INC.
445 W. MICHIGAN AVE. SUITE 101, KALAMAZZO, MI 49007
(616) 381-2222 FAX (616) 381-2188

TRAFFIC CONSULTANT:
THE TRAFFIC GROUP
40 W. CHESAPEAKE AVE. SUITE 600, TOWSON, MD 21204
(410) 583-8405 FAX (410) 321-8458

REVISIONS
1 REVISION NO. 1 - 11-29-94
2 REVISION NO. 2 - TITLE OF CONTENTS - 01-20-95

10227 WINCOPIN CIRCLE, SUITE 700 COLUMBIA, MD 21044
BALTO. (410)995-0015 • WASH./VA. (301)621-6020

ABBREVIATIONS

ANCHOR BOLT		JOIST	
ACCESS DOOR		JOINT BEARING	
AMERICANS W/ DISABILITIES ACT		JOINT	
AIR HANDLING UNIT			
ALUMINUM		KITCHEN	
ACCESS PANEL			
APPROXIMATE		LAMINATE(D)	
AREA OF RESCUE ASSISTANCE		LAUNDRY	
ARCHITECT		LAVATORY	
ASPHALT		LOAD	
ASSOCIATED/ASSOCIATION		LIVE LOAD	
		LOCATE/LOCATION	
BOTTOM		LONG LEG VERTICAL	
BATH ROOM		LIGHT	
BALCONY			
BASE CABINET		MASONRY	
BOARD		MAXIMUM	
BEAM		MASTER BEDROOM	
BUILDING OFFICIALS		MEDIUM DENSITY OVERLAY	
BOCA + CODE ASSOCIATION		MECHANICAL	
BEDROOM		METAL	
BEARING		MANUFACTURER	
BRICK		MIRROR	
BACKSPLASH		MISCELLANEOUS	
		MICRO LAM	
COURSE (MASONRY)		MASONRY OPENING	
CABINET(S)		MARBLE	
CANTILEVER(ED)		MOUNTED	
CEILING DIFFUSER			
CENTER LINE		NATIONAL ELECTRIC CODE	
CEILING		NATIONAL FIRE	
CLOSET		NEW	
CONCRETE MASONRY UNIT		NOT IN CONTRACT	
COUNTER		NUMBER	
COLUMN		NOT TO SCALE	
CONCRETE			
CONDITION		ON CENTER	
CONTINUOUS		OVERFLOW SCUPPER	
CONTROL JOINT		OVERHEAD	
CORNER		OPTIONAL	
CARPET			
CABINET		PLASTIC LAMINATE	
CERAMIC TILE		PARTIAL	
CUBIC		PROTECTION ASSOC.	
		PLATE	
DOUBLE		PLASTIC	
DETAIL		PLACES	
DIMENSION		PLYWOOD	
FOOD DISPOSER		PANEL	
DEAD LOAD		PREFABRICATED	
DOWN		PROJECT(ED)	
DARK ROOM		POUNDS PER SQUARE FOOT	
DOOR		POUNDS PER SQUARE INCH	
DRAIN		PAINTED	
DOWNSPOUT		PRESSURE TREATED	
DRAWING(S)			
EXTERIOR INSULATION FINISH SYSTEM		R RISER/RADIUS	
ELEVATION		RETURN AIR GRILLE	
ELECTRICAL		ROUND DUCT	
ELEVATOR		REFRIGERATOR	
ETHYLENE PROPYLENE DIENE TERPOLYMER		REINFORCE (D/NG)	
EQUAL		REQUIRED	
EXISTING		RANGE	
EXPANSION		ROOF	
EXPANSION JOINT		ROUGH OPENING	
EXTERIOR		SOLDIER (MASONRY)	
		SHELF, SHELVES	
FLOOR DRAIN		SPLASH BLOCK	
FOUNDATION		SOLID CORE	
FINISHED FLOOR		SMOKE DETECTOR	
FINISH OR FINISHED		SECTION	
FIXTURE		SQUARE FEET	
FLEXIBLE DUCT		SHINGLE(S)	
FLOOR		SHOWER	
FLUORESCENT		SQUARE INCHES	
FIRE RETARDANT		SIMILAR	
FEET		SINK	
FOOTING		SUMP PUMP	
FIRE EXTINGUISHER		SQUARE	
		SHELF + ROD	
GALVANIZED		STEEL	
GARAGE		STAIR	
GLASS BLOCK		STRUCTURE/STRUCTURAL	
GROUND FAULT INTERRUPTER		SUPPLIER	
GLAZING OR GLASS		SHEET VINYL	
GRADE		TREAD (STAIRS)	
GUTTER		TRUSS	
GYPSUM WALL BOARD		THRESHOLD	
GYPSUM		TYPICAL CONDITION	
GYP. BD. GYPSUM BOARD			
HEADER (MASONRY)		V.B. VAPOR BARRIER	
HOSE BIB		VCT VINYL COMPOSITE TILE	
HANDICAPPED		VERT. VERTICAL	
HOLLOW CORE		V.I.F. VERIFY IN FIELD	
HARDWARE			
HEAD		W. WITH	
HOLLOW METAL		WC WATER CLOSET/TOILET	
HORIZ. HORIZONTAL		WOOD	
HEIGHT		WEIGHT	
INCHES			
INCAND INCANDESCENT			
INCL. INCLUDED			
INSUL. INSULATION OR INSULATED			
INT. INTERIOR			

LIST OF ARCHITECTURAL SYMBOLS

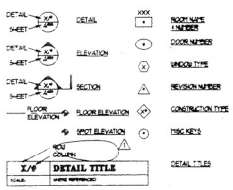

LIST OF MATERIALS

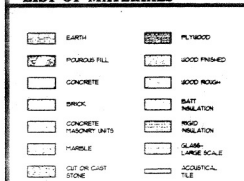

CODE REQUIREMENTS

APPLICABLE CODES: B.O.C.A. 1993
N.F.P.A. 101, 1994
N.F.P.A. 88A, 1994

USE GROUP: BOCA 313: S-2, OPEN PARKING STRUCTURE

EXTERIOR WALL OPENINGS: BOCA 406.11 & NFPA 88A 2.1.1 & 3.1.3

GROUND LEVEL	EXTERIOR WALLS	3,400 SF OPEN / 9,577 SF TOTAL = 35%
	CENTER WALL	831 SF OPEN / 1,966 SF TOTAL = 42%
TYPICAL LEVEL	EXTERIOR WALLS	3,066 SF OPEN / 8,302 SF TOTAL = 37%
	CENTER WALL	966 SF OPEN / 1995 SF TOTAL = 48%
OPEN PERIMETER: BOCA 406.11		507'-4" OPEN / 790'-8" TOTAL = 64%

CONSTRUCTION TYPE: BOCA 602: 2c

EXTERIOR WALLS (0' - 5' FROM ADJ.):	0 HOURS (SEE BELOW)
COLUMNS:	0 HOURS
FLOORS:	0 HOURS
EGRESS STAIRS:	2 HOURS
OFFICE/GARAGE, NFPA 88A 3.2.2:	1 HOUR

EXTERIOR WALL FIRE RATING, BOCA 1405.2:

(0' - 5' FROM ADJ.):	2 HOURS
(5' - 10' FROM ADJ.):	1 HOUR
(GREATER THAN 10' FROM ADJ.):	NONE

HEIGHT AND AREA LIMITATIONS, BOCA 503.1, BOCA 406.4

AREA ALLOWED:	50,000
PROPOSED:	33,462 GSF
HEIGHT ALLOWED:	85'-0", 8 STORIES
PROPOSED:	47'-9", 5-STORIES

OCCUPANT LOAD, BOCA 1004.1.2: 33,462 GSF / 200 = 168 OCCUPANTS

EGRESS WIDTH REQUIRED, BOCA 1005.2 & NFPA 101 5.3.3.1.

REQUIRED:	168 x 0.3 = 50" PER LEVEL
PROPOSED:	84" (STAIR # 1 & 7)

GENERAL NOTES

1. DO NOT SCALE DRAWINGS. USE WRITTEN DIMENSIONS ONLY.
2. THE CONTRACTOR SHALL VERIFY ALL DIMENSIONS, GRADES, BOUNDARIES AND CONSTRUCTION BEFORE PROCEEDING WITH THE WORK AND SHALL IMMEDIATELY REPORT ANY DISCREPANCIES TO THE ARCHITECT.
3. ALL MATERIALS AND WORK SHALL COMPLY WITH ALL APPLICABLE CODES AND REGULATIONS.
4. ALL DIMENSIONS, NOTES, FINISHES AND FIXTURES SHOWN ON TYPICAL FLOOR PLANS, SECTIONS OR DETAILS SHALL APPLY TO ALL SIMILAR SYMMETRICAL OR OPPOSITE HAND PLANS, SECTIONS OR DETAILS.
5. ALL WOOD AND BLOCKING AND PLYWOOD TO BE FIRE RETARDANT TREATED. MISCELLANEOUS BLOCKING AT ROOF AND COPING SHALL BE MOISTURE RESISTANT.
6. WORK SHALL CONFORM TO LOCAL BUILDING CODES AND ORDINANCES AND OTHER AGENCIES HAVING JURISDICTION. THE RULES AND REGULATIONS OF OSHA SHALL BE ADHERED TO FOR THIS PROJECT.
7. WORK SHALL CONFORM WITH A.D.A. 1991 AND MARYLAND HANDICAPPED CODE, ANSI/ATU 1986.

KEY PLAN

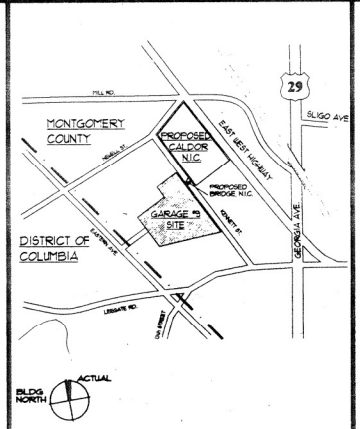

LOCATION MAP

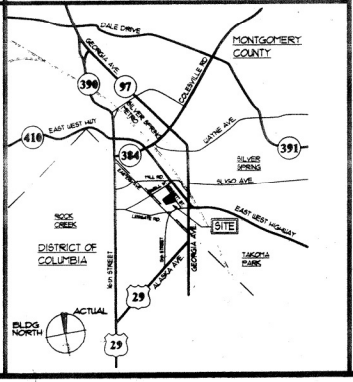

LIST OF DRAWINGS

GENERAL:

G001	GENERAL COVER SHEET
G002	EGRESS PLAN
G003	PARKING PLAN

DEMOLITION:

D101	DEMOLITION PLAN

CIVIL:

C100	SITE IMPROVEMENTS PLAN
C102	STORM DRAINAGE PROFILES & DETAILS
C103	EROSION & SEDIMENT CONTROL PLAN
C104	SEDIMENT CONTROL DETAILS & NOTES
C105	STORM WATER MANAGEMENT STRUCTURE DETAILS

TRAFFIC CONTROL:

TM1	TRAFFIC CONTROL PLAN - PHASE I

LANDSCAPE:

L101	PLANTING PLAN
L102	NORTH PAVING PLAN
L103	SOUTH PAVING PLAN

ARCHITECTURAL:

A601	GROUND LEVEL PLAN & DETAILS
A602	FIRST LEVEL PLAN & WALL CONSTRUCTION TYPES
A603	SECOND LEVEL PLAN
A604	THIRD LEVEL PLAN
A605	FOURTH LEVEL & ROOF PLANS
A606	ALTERNATE # - 41,667 DECK PLANS, SECTIONS & ELEVATIONS
A301	ELEVATIONS
A302	ELEVATIONS & DETAILS
A303	BUILDING SECTIONS
A304	WALL SECTIONS & DETAILS
A501	STAIR # 4 ELEVATOR # 4 'S' PLANS, SECTIONS & DETAILS
A502	STAIR # 4 ELEVATOR # 4 'S' PLANS, SECTIONS & DETAILS
A503	STAIR #, 'S' & 'M' PLANS, SECTIONS & DETAILS
A504	ENLARGED PLANS, SCHEDULES
A505	DOOR & WINDOW SCHEDULES & DETAILS
A401	SIGN PLANS
A402	EXTERIOR SIGN PLANS, SECTIONS, & DETAILS
A403	INTERIOR SIGN SCHEDULE & DETAILS
A701	ENTRANCES & EXTERIOR SIGN PLANS, ELEVATIONS & DETAILS
A301	BRIDGE PLANS (FOR COORDINATION ONLY N.I.C.)
A501	BRIDGE PLANS (FOR COORDINATION ONLY N.I.C.)

STRUCTURAL:

S401	FOUNDATION PLAN
S402	FIRST LEVEL FRAMING PLAN
S403	SECOND LEVEL FRAMING PLAN
S404	THIRD LEVEL FRAMING PLAN
S405	FOURTH LEVEL FRAMING PLAN
S406	STAIR NO.2 FRAMING PLAN
S407	STAIR NO.1 FRAMING PLAN
S408	STAIR NO. 1 FRAMING PLAN
S501	DETAILS (CAST IN PLACE)
S502	STANDARD SECTIONS (PRECAST)
S503	STANDARD DETAILS (PRECAST)
S504	MISCELLANEOUS SECTIONS
S505	STRUCTURAL NOTES

MECHANICAL/PLUMBING:

MP101	COVER SHEET
MP102	GROUND LEVEL PLAN
MP103	FIRST LEVEL PLAN
MP104	SECOND LEVEL PLAN
MP105	THIRD LEVEL PLAN
MP106	FOURTH LEVEL PLAN
MP107	ALTERNATE 1
MP108	PLUMBING RISERS

ELECTRICAL:

E601	SITE PLAN
E602	GROUND LEVEL PLAN
E603	FIRST LEVEL PLAN
E604	SECOND LEVEL PLAN
E605	THIRD LEVEL PLAN
E606	FOURTH LEVEL PLAN
E607	SCHEDULES, LEGEND & RISERS
E608	PANEL SCHEDULES

RED LINE AS Builts

PROJECT NAME: PARKING GARAGE No. 9 — MONTGOMERY, COUNTY
SHEET TITLE: COVER SHEET — GENERAL NOTES
JOB NUMBER: 106-94
DATE: 12-01-94
SHEET NUMBER: G001

ARCHITECTS • PLANNERS
DEVELOPMENT CONSULTANTS

DRBrasher